


5 A37
10-4-63

WATER WELL DRILLERS LOG

Date: 10-4, 1963, Driller: Mr Donald & Neil County Clarke
(Name)

(1) Owner of Land: <u>Harrison Long</u> (Name)	Description & Color of Materials Sand, Clay, Red Clay, Shell, etc.	Thick- ness Feet	Depth Feet
<u>Enterprise, Miss</u> (Address)	Clay	0	7
(2) Location: <u>1/4, 1/4, Sec. 22 T. R.</u> <u>4N 14E</u>	Sand	7	10
<u>2 miles west</u> , of <u>Enterprise</u> (distance) (direction) (Nearest Town)	Chalk	15	19
(3) Topography: <u>Hilly</u> (Hilly) (Flat) (Level)	Sand & clay shale	19	30
(4) Purpose of Well: <u>Domestic</u> (Domestic Irrigation Municipal, Industrial, Other)	shale	30	40
Information upon completion of well:	Sand - sandy clay	40	70
(1) Diameter <u>3 7/8</u> inches.	shale	70	110
(2) Total Depth <u>280</u> feet.	limy shale & lime	110	119
(3) Water Level <u>45</u> feet below top of ground.	Hard lime	119	127
(4) Cased to <u>275</u> , Size <u>4 x 2</u>	shale & lime	127	137
(5) Screen: Size <u>2"</u> , Length <u>5'</u>	sand	137	145
(6) Were any formations sealed against pollution? _____ yes, _____ no.	limy shale	145	195
If YES depth of formation _____	Sandy	195	201
Why _____	limy shale & lime	201	245
Drillers Remarks: _____	shale w/ lime sh	245	270
_____	Coarse sand	270	280

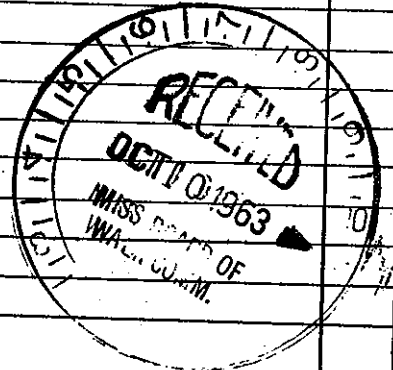

Well No. 116

(Use Back Side)

Mail this copy to Board of Water Commissioners 429 Miss. St. Jackson, Miss.