

WATER WELL DRILLERS LOG

CLARKE
A38
4-64

WATER WELL DRILLERS LOG

Date: April, 1964, Driller: Peeples Drilling Co Clarke
(Name)

(1) Owner of Land: Wes Pasley
(Name)
Enterprise, Miss
(Address)

(2) Location: SW 1/4, SW 1/4, Sec. 22 T4R14
2 miles West of Enterprise
(distance) (direction) (Nearest town)

(3) Topography: Hilly
(Hilly) (Flat) (Level)

(4) Purpose of Well: Domestic
(Domestic Irrigation
Municipal, Industrial, Other)

Description & Color of Materials Sand, Clay, Red Clay, Shell, etc.	Thick- ness Feet	Depth Feet
Red sandy clay	15	15
yellow sand	20	35
Blue marl	13	48
yellow sand	15	63
Brown shale	10	73
Blue shale	32	105
Rock + Blue marl Bed	21	126
Soft Green Sand	14	140
Blue marl + Rock	112	252
Gray sandy shale	15	267
White sand	69	336


Information upon completion of well:

- (1) Diameter 4 inches.
- (2) Total Depth 336 feet.
- (3) Water Level 40 feet below top of ground.
- (4) Cased to 147', Size 4"
- (5) Screen: Size NONE, Length _____
- (6) Were any formations sealed against pollution?
_____ yes, _____ no.

If YES depth of formation _____

Why _____

Drillers Remarks: _____

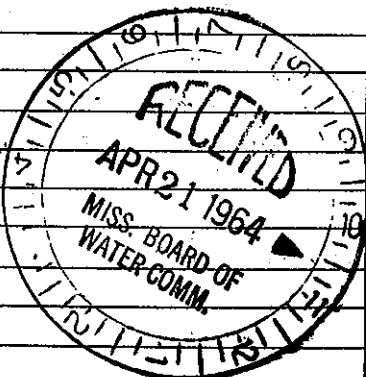

Well No.

(Use Back Side)

Mail this copy to Board of Water Commissioners 429 Miss. St. Jackson, Miss.