

WATER COMMISSIONERS

WATER WELL DRILLERS LOG

CLARK

A 39
10-65

Date: Oct. 1965, Driller: Peoples Drilling Co County, Clarke

(Name)

(1) Owner of Land: Frank Price
(Name)
Rt 2 Enterprise, Miss
(Address)
(2) Location: 1/4, 1/4, Sec. 20 4N14E T. R.
3 1/2 miles W of Enterprise
(distance) (direction) (Nearest Town)
(3) Topography: Hilly
(Hilly) (Flat) (Level)
(4) Purpose of Well: Home
(Domestic Irrigation
Municipal, Industrial, Other)

Description & Color of Materials Sand, Clay, Red Clay, Shell, etc.	Thick- ness Feet	Depth Feet
Red Clay	19	19
Yellow Sand	8	27
Yellow Sandy clay & Sand streak	83	110
Fine yellow Sand & clay streaks	37	147
Yellow Sandy clay	10	157
Gray Sandy Shale	11	168
Blue marl	32	200
Blue marl & Rock	20	220
Blue marl & Sand streak	20	240
Blue marl & Rock	110	350
Gray Sandy Shale	10	360
Coarse White Sand & small shale streak	39	399

Information upon completion of well:

(1) Diameter 4 inches.

(2) Total Depth 399 feet.

(3) Water Level 115 feet below top of ground.

(4) Cased to 189', Size 4"


(5) Screen: Size NONE, Length _____

(6) Were any formations sealed against pollution?
_____ yes, _____ no.

If YES depth of formation _____

Why _____

Drillers Remarks: _____

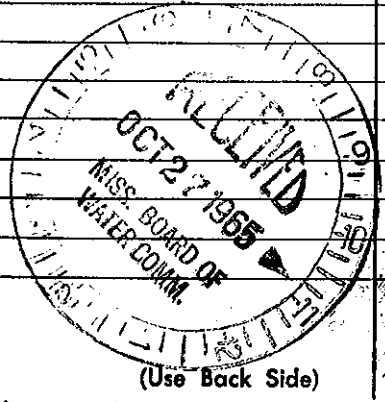

Well No.

Mail this copy to Board of Water Commissioners 429 Miss. St. Jackson, Miss.