

CLARK

MISSISSIPPI BOARD OF WATER COMMISSIONERS

4 A 41

4-65


WATER WELL DRILLERS LOG

P

Date: April, 19 65, Driller: Peoples Drilling, County: Clark

(Name)

| (1) Owner of Land: | Description & Color of Materials Sand, Clay, Red Clay, Shell, etc. | Thick- ness Feet | Depth Feet |
|--|---|------------------------|---------------|
| Tim O'Brien <small>(Name)</small> Eutaw <small>(Address)</small> | Red sandy clay yellow sand | 18 67 | 18 85 |
| (2) Location: 1/4, 1/4, Sec. 27 T. R. 4N 14E 2 miles W of Eutaw <small>(distance) (direction) (Nearest Town)</small> | | | |
| (3) Topography: Hilly <small>(Hilly) (Flat) (Level)</small> | | | |
| (4) Purpose of Well: Home <small>(Domestic Irrigation Municipal, Industrial, Other)</small> | | | |
| Information upon completion of well: | | | |
| (1) Diameter 2 inches. | | | |
| (2) Total Depth 85 feet. | | | |
| (3) Water Level 63 feet below top of ground. | | | |
| (4) Cased to 79, Size 2 | | | |
| (5) Screen: Size 2, Length 4 | | | |
| (6) Were any formations sealed against pollution? _____ yes, _____ no. | | | |
| If YES depth of formation _____ | | | |
| Why _____ | | | |
| Drillers Remarks: _____ | | | |

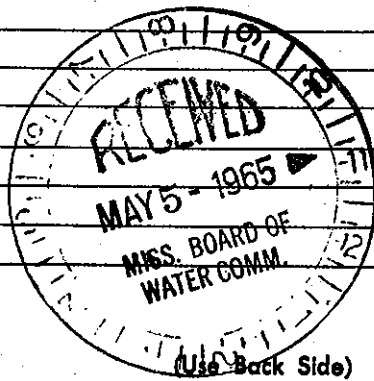

Well No.

Mail this copy to Board of Water Commissioners 429 Miss. St. Jackson, Miss.