

6 A 43

4-9-65

WATER WELL DRILLERS LOG

Date: 4-9, 1965, Driller: McDonald & Hill, Inc. County: Lauderdale

(Name)

(1) Owner of Land: Bobbie Willerson  
 (Name)  
Rt # 2 W Enterprise, Miss.  
 (Address)  
 (2) Location: 1/4, 1/4, Sec. 19 4N 14E T. R.  
5 miles W of Enterprise  
 (distance) (direction) (Nearest town)  
 (3) Topography:  (Hilly)  (Flat)  (Level)  
 (4) Purpose of Well: Domestic  
 (Domestic Irrigation, Municipal, Industrial, Other)

Description & Color of Materials Sand, Clay, Red Clay, Shell, etc.	Thick- ness Feet	Depth Feet
Clay & sand	0	50
br. shale & lig	50	76
C sand	76	130
H shale	130	155
Soft shale	155	160
H shale	160	180
lime rock	180	200
no green sand	200	210
H shale & lime rock	210	214
Steady shale	214	217
lime rock & shale	217	272
C sand	272	274
shale & lime rock	274	282
C sand	282	288
shale & lime rock	288	330
sandy shale	330	345
fine sand & n. sand	345	355
C sand	355	365
shale	365	370


Information upon completion of well:

(1) Diameter 4 inches.  
 (2) Total Depth 370 feet.  
 (3) Water Level 59 feet below top of ground.  
 (4) Cased to 148 1/2, Size 4"  
 (5) Screen: Size \_\_\_\_\_, Length \_\_\_\_\_  
 (6) Were any formations sealed against pollution?  
 \_\_\_\_\_ yes, \_\_\_\_\_ no.

If YES depth of formation \_\_\_\_\_

Why \_\_\_\_\_

Drillers Remarks: \_\_\_\_\_

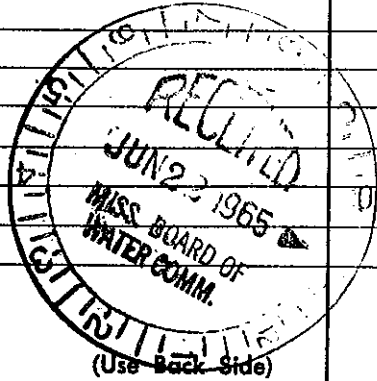

Well No. \_\_\_\_\_