


CLARKE MISSISSIPPI BOARD OF WATER COMMISSIONERS

A 44
8-64

WATER WELL DRILLERS LOG

Date: Aug, 1964, Driller: Peeples Drilling Co County Clarke
(Name)

(1) Owner of Land:	Description & Color of Materials Sand, Clay, Red Clay, Shell, etc.	Thick- ness Feet	Depth Feet
(Name) <u>Charlie Coines</u>	<u>Red Sandy clay</u>	15	15
(Address) <u>Rt 1 Pithman, Miss</u>	<u>yellow sand & clay</u>	27	42
<u>4N 14E</u>	<u>Yellow Sand & Clay</u>		
(2) Location: <u>1/4</u> , <u>1/4</u> , Sec. <u>10</u> T. <u>R.</u>	<u>streaks</u>	33	75
<u>3 1/2</u> miles <u>NW</u> of <u>Pithman</u>	<u>blue clay</u>	19	94
(distance) (direction) (Nearest Town)	<u>blue marl & rock</u>		
(3) Topography: <u>Hilly</u>	<u>streaks</u>	36	130
(Hilly) (Flat) (Level)	<u>Green Sand & chert</u>	21	151
(4) Purpose of Well: <u>Home</u>	<u>blue marl & rock</u>	101	252
(Domestic Irrigation Municipal, Industrial, Other)	<u>Cray Sandy shale</u>	14	266
Information upon completion of well:	<u>White Sand &</u>		
(1) Diameter <u>4</u> inches.	<u>small pebbles shale</u>		
(2) Total Depth <u>304</u> feet.	<u>streaks</u>	38	304
(3) Water Level <u>90</u> feet below top of ground.			
(4) Cased to <u>168'</u> , Size <u>4"</u>			
(5) Screen: Size <u>NOV 15</u> Length _____			
(6) Were any formations sealed against pollution?			
_____ yes, _____ no.			
If YES depth of formation _____			
Why _____			
Drillers Remarks: _____			

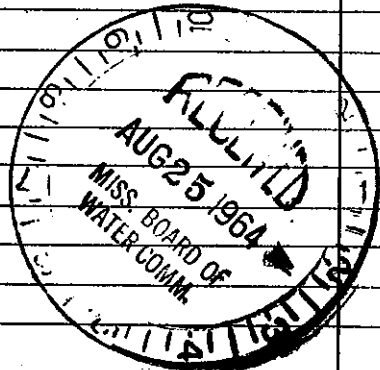

Well No.

(Use Back Side)

Mail this copy to Board of Water Commissioners 429 Miss. St. Jackson, Mis.