

CLARKE
A 47
9-21-63

MISSISSIPPI BOARD OF WATER COMMISSIONERS


WATER WELL DRILLERS LOG

McDONALD & HILL, Inc.

Date: 9-21, 1963, Driller: P. O. Box 81 County Land.

MERIDIAN: MISSISSIPPI

(1) Owner of Land:	Description & Color of Materials Sand, Clay, Red Clay, Shell, etc.	Thick- ness Feet	Depth Feet
R. D. McCRANEY (Name)	Clay	0	16
Rt #1 Enterprise (Address)	B. shale	16	55
Location: 1/4, 1/4, Sec. 19 4N 14E T. R.	Sandy	55	58
6 miles W of Enterprise (distance) (direction) (Nearest Town)	B. shale	58	65
(3) Topography:	W. clay	65	75
(Hilly) (Flat) (Level)	fine sand	75	95
(4) Purpose of Well: Domestic (Domestic Irrigation Municipal, Industrial, Other)	#12 sand	95	120
Information upon completion of well:			
(1) Diameter 2 inches.			
(2) Total Depth 120 feet.			
(3) Water Level 70 feet below top of ground.			
(4) Cased to 110, Size 2			
(5) Screen: Size #10, Length 5			
(6) Were any formations sealed against pollution?			
yes, no.			
If YES depth of formation			
Why			
Drillers Remarks:			

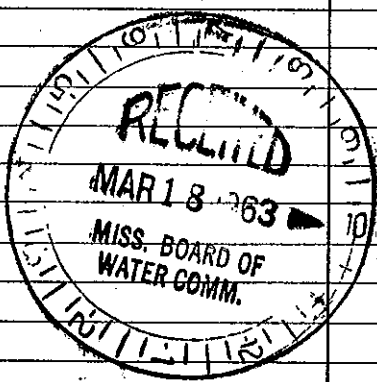

Well No.

(Use Back Side)

Mail this copy to Board of Water Commissioners 429 Miss. St. Jackson, Miss.