

CLARK  
A 49  
2-63

WATER WELL DRILLERS LOG

Date: Feb, 1963, Driller: Peoples Drilling Co. County: Clark  
(Name)

(1) Owner of Land:	Description & Color of Materials Sand, Clay, Red Clay, Shell, etc.	Thick- ness Feet	Depth Feet
McGrew (Name)	Red sandy clay	21	21
Enterprise Miss (Address)	yellow sand & clay	43	84
(2) Location: 1/4, 1/4, Sec. 18 T. R. 4N 10E	Yellow sand	36	120
7 miles W of Enterprise (distance) (direction) (Nearest Town)			
(3) Topography: Hilly (Hilly) (Flat) (Level)			
(4) Purpose of Well: Domestic (Domestic Irrigation Municipal, Industrial, Other)			


Information upon completion of well:

- (1) Diameter 2 inches.
- (2) Total Depth 120 feet.
- (3) Water Level 65 feet below top of ground.
- (4) Cased to 114, Size 2"
- (5) Screen: Size 2", Length 6'
- (6) Were any formations sealed against pollution?  
yes,  no.

If YES depth of formation \_\_\_\_\_

Why \_\_\_\_\_

Drillers Remarks: \_\_\_\_\_

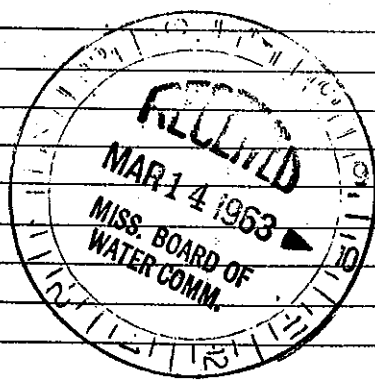

Well No. \_\_\_\_\_

(Use Back Side)

Mail this copy to Board of Water Commissioners 429 Miss. St. Jackson, Miss