

CLARKE MISSISSIPPI BOARD OF WATER COMMISSIONERS

5 A50

13 P

10-12-61

WATER WELL DRILLERS LOG

~~Boonville~~

Date: 10-12, 1961, Driller: McDonald Hill County: LAUDERDALE

(Name)

(1) Owner of Land: SIBLEY (Name)

ENTERPRISE MISS (Address)

(2) Location: 1/4, 1/4, Sec. 34 T. R. UN 14E

3 miles SOUTH of ENTERPRISE (distance) (direction) (Nearest Town)

(3) Topography: X (Hilly) (Flat) (Level)

(4) Purpose of Well: Domestic (Domestic Irrigation, Municipal, Industrial, Other)

Description & Color of Materials Sand, Clay, Red Clay, Shell, etc.	Thick- ness Feet	Depth Feet
CLAY	0	20
SAND CLAY	20	34
SHALE	34	80
SANDY LIME	80	120
BROWN SHALE	120	135
SANDY LIME	135	140
FINE SAND	140	155
SAND NO 12	155	170

Information upon completion of well:

(1) Diameter: 3 1/2 inches.

(2) Total Depth: 170' feet.

(3) Water Level: 126' feet below top of ground.

(4) Cased to: 160', Size: 2"


(5) Screen: Size: 2", Length: 5'

(6) Were any formations sealed against pollution?  
yes, no.

If YES depth of formation

Why

Drillers Remarks:

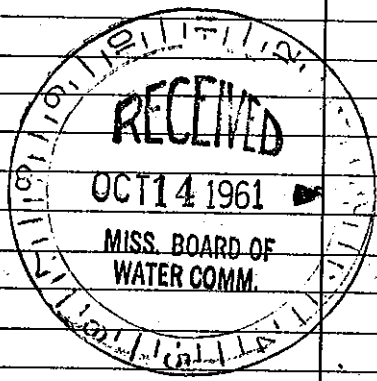

(Use Back Side)

Well No.

Mail this copy to Board of Water Commissioners 429 Miss. St. Jackson, Miss.