


CLARKE
 5 ~~B~~ A51
 4-65

MISSISSIPPI BOARD OF WATER COMMISSIONERS

WATER WELL DRILLERS LOG

Date: April, 1965, Driller: Papson Drilling Co County Clarke
 (Name)

(1) Owner of Land:	Description & Color of Materials Sand, Clay, Red Clay, Shell, etc.	Thick- ness Feet	Depth Feet
<u>Frank Shultz</u> (Name) <u>Enterprise</u> (Address)	<u>yellow clay</u>	<u>12</u>	<u>12</u>
(2) Location: <u>1/4</u> , <u>1/4</u> , Sec <u>13</u> <u>N 1/4 E</u> T <u>R</u>	<u>yellow sand rock</u>	<u>3</u>	<u>15</u>
<u>1/2</u> miles <u>N</u> of <u>Enterprise</u> (distance) (direction) (Nearest Town)	<u>white sand</u>	<u>15</u>	<u>30</u>
(3) Topography: <u>flat</u> (Hilly) (Flat) (Level)	<u>blue marl + rock</u>	<u>117</u>	<u>147</u>
(4) Purpose of Well: <u>Home</u> (Domestic Irrigation Municipal, Industrial, Other)	<u>blue sandy shale</u>	<u>21</u>	<u>168</u>
	<u>white sandy shale</u>		
	<u>shale</u>	<u>32</u>	<u>200</u>
	<u>blue sandy shale</u>	<u>10</u>	<u>210</u>
Information upon completion of well:			
(1) Diameter <u>4</u> inches.			
(2) Total Depth <u>200</u> feet.			
(3) Water Level <u>2</u> feet below top of ground.			
(4) Cased to <u>42'</u> , Size <u>4"</u>			
(5) Screen: Size <u>NONE</u> , Length _____			
(6) Were any formations sealed against pollution? _____ yes, _____ no.			
If YES depth of formation _____			
Why _____			
Drillers Remarks: _____			

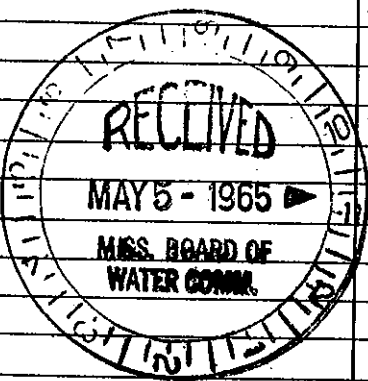

Well No.

(Use Back Side)

Mail this copy to Board of Water Commissioners 429 Miss. St. Jackson, Miss.