

CLARKE MISSISSIPPI BOARD OF WATER COMMISSIONERS

5 ~~B52~~ A52
5-62

WATER WELL DRILLERS LOG

Date: May, 1962, Driller: Reeple + Rutledge County Clarke

(Name)

(1) Owner of Land:	Description & Color of Materials Sand, Clay, Red Clay, Shell, etc.	Thick- ness Feet	Depth Feet
<u>W. E. Robinson</u> (Name) <u>Enterprise, Miss</u> (Address)	Top soil to yellow sand	21	21
(2) Location: <u>Town of Enterprise</u> <u>1/4, 1/4, Sec. 24 4N 14E</u> <u>T. R.</u> <u>Town of Enterprise</u> miles (distance), of (direction), of (Nearest Town)	Green Rock + small green shale streaks	69	90
(3) Topography: <u>Flat</u> (Hilly) (Flat) (Level)	White sand + small Rock breaks	8	98
(4) Purpose of Well: <u>Domestic</u> (Domestic Irrigation Municipal, Industrial, Other)	Rock + green shale streaks	70	168
	Gray sandy shale	16	185
	White coarse sand	35	220
	Fine white sand	-	-


Information upon completion of well:

- (1) Diameter 2 inches.
- (2) Total Depth 216 feet.
- (3) Water Level 16 feet below top of ground.
- (4) Cased to 210, Size 2"
- (5) Screen: Size 2", Length 6'
- (6) Were any formations sealed against pollution?
 yes, no.

If YES depth of formation _____

Why _____

Drillers Remarks: _____

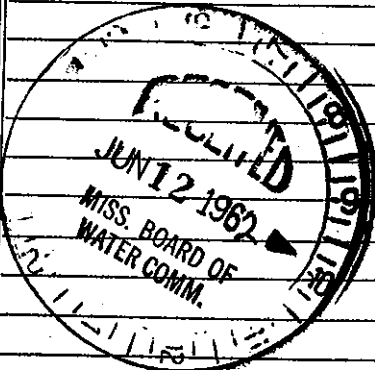

Well No.

(Use Back Side)

Mail this copy to Board of Water Commissioners 429 Miss. St. Jackson, Miss.