

MISSISSIPPI BOARD OF WATER COMMISSIONERS

CLARK  
 5 A53  
 7-63

WATER WELL DRILLERS LOG

Date: July, 1963, Driller: Reaper Drilling Co County Clarke  
 (Name)

(1) Owner of Land: <u>Joe Cumbly</u> (Name) <u>Enterprise, Miss.</u> (Address)	Description & Color of Materials Sand, Clay, Red Clay, Shell, etc.	Thick- ness Feet	Depth Feet
(2) Location: <u>Town of Enterprise N 1/4</u> <u>1/4, 1/4, Sec. 12 T. R.</u> <u>Town of Enterprise</u> miles of (distance) (direction) (Nearest Town)			
(3) Topography: <u>Flat</u> (Hilly) (Flat) (Level)	<u>Yellow Sandy clay</u>	<u>10</u>	<u>10</u>
(4) Purpose of Well: <u>Domestic</u> (Domestic Irrigation Municipal, Industrial, Other)	<u>Yellow sand &amp; gravel</u>	<u>11</u>	<u>21</u>
	<u>Green sand rock</u>	<u>14</u>	<u>35</u>
	<u>Green sand</u>	<u>13</u>	<u>48</u>
	<u>Blue marl &amp; rock</u>		
	<u>shale</u>	<u>46</u>	<u>94</u>
	<u>Rock &amp; small marl</u>		
	<u>shale</u>	<u>74</u>	<u>168</u>
	<u>Gray sandy shale</u>	<u>11</u>	<u>179</u>
	<u>White sand</u>	<u>16</u>	<u>195</u>
	<u>White sand &amp; marl</u>		
	<u>shale shale</u>	<u>36</u>	<u>231</u>

Information upon completion of well:

(1) Diameter 4 inches.

(2) Total Depth 231' feet.

(3) Water Level 8 feet below top of ground.

(4) Cased to 85', Size 4"


(5) Screen: Size NONE, Length \_\_\_\_\_

(6) Were any formations sealed against pollution?  
 \_\_\_\_\_ yes, \_\_\_\_\_ no.

If YES depth of formation \_\_\_\_\_

Why \_\_\_\_\_

Drillers Remarks: \_\_\_\_\_

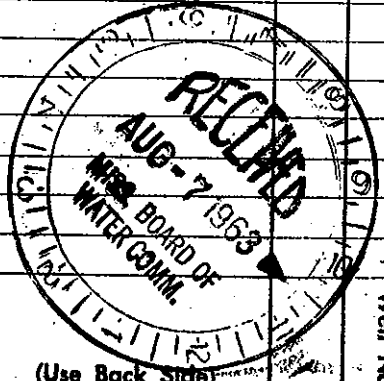

Well No. \_\_\_\_\_

(Use Back Side)

Mail this copy to Board of Water Commissioners 429 Miss. St. Jackson, Miss