

WATER COMMISSIONERS

CLARKE
WATER WELL DRILLERS LOG

P

Date: July 7-63, 1963, Driller: Reaper Pulling Co County Clarke
(Name)

(1) Owner of Land: Green
(Name)
Entapuis, Miss
(Address)

(2) Location: 1/4, 1/4, Sec. 24 4N 14E
Entapuis
miles of (direction) of (Nearest Town)

(3) Topography: Flat
(Hilly) (Flat) (Level)

(4) Purpose of Well: Domestic
(Domestic Irrigation, Municipal, Industrial, Other)

Description & Color of Materials Sand, Clay, Red Clay, Shell, etc.	Thick- ness Feet	Depth Feet
<u>Yellow sandy clay</u>	<u>8</u>	<u>8</u>
<u>Yellow Sand & Gravel</u>	<u>10</u>	<u>18</u>
<u>Green Sand Rock</u>	<u>13</u>	<u>31</u>
<u>Blue Marl & Rock</u>		
<u>strata</u>	<u>53</u>	<u>84</u>
<u>Rock & marl strata</u>	<u>43</u>	<u>147</u>
<u>Brown sandy shale</u>	<u>11</u>	<u>158</u>
<u>White Sand</u>	<u>18</u>	<u>176</u>
<u>White Sand & small</u>		
<u>Brown shale</u>	<u>24</u>	<u>200</u>
<u>Brown sandy shale</u>	<u>10</u>	<u>210</u>

Information upon completion of well:

(1) Diameter 4 inches.

(2) Total Depth 210 feet.

(3) Water Level 12 feet below top of ground.

(4) Cased to 42', Size 4"


(5) Screen: Size NONE, Length _____

(6) Were any formations sealed against pollution?
_____ yes, _____ no.

If YES depth of formation _____

Why _____

Drillers Remarks: _____

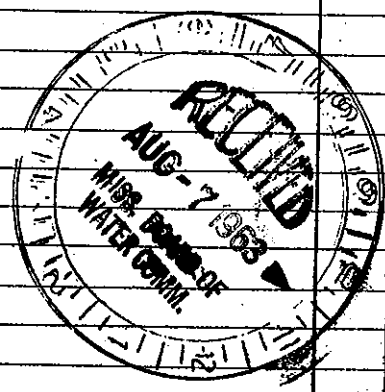

Well No.

(Use Back Side)

Mail this copy to Board of Water Commissioners 429 Miss. St. Jackson, Miss