

CLARKE WATER WELL DRILLING LOG

51 ASS B 2-64

Date: Feb, 19, Driller: Peoples Drilling, County: Clarke

(Name)

(1) Owner of Land: Monroe Allen

(Name)

Enterprise, Miss.

(Address)

(2) Location: 1/4, 1/4, Sec. 24 NW 14E

Town of Enterprise

miles, of (distance) (direction) (Nearest Town)

(3) Topography: flat

(Hilly) (Flat) (Level)

(4) Purpose of Well: Construction Yard

(Domestic Irrigation Municipal, Industrial, Other)

Description & Color of Materials Sand, Clay, Red Clay, Shell, etc.

Thick-ness Feet

Depth Feet

| | | |
|---------------------|-----|-----|
| yellow sand | 18 | 18 |
| Sandy Rock | 14 | 32 |
| Green Sand | 20 | 52 |
| Blue marl & rock | 116 | 168 |
| Blue Sandy shale | 5 | 173 |
| white sand | 57 | 230 |
| Sand & shale streak | 7 | 237 |

Information upon completion of well:

(1) Diameter 4 inches.

(2) Total Depth 231 feet.

(3) Water Level 12 feet below top of ground.

(4) Cased to 63', Size 4"

(5) Screen: Size NONE, Length


(6) Were any formations sealed against pollution?

yes, no.

If YES depth of formation

Why

Drillers Remarks:

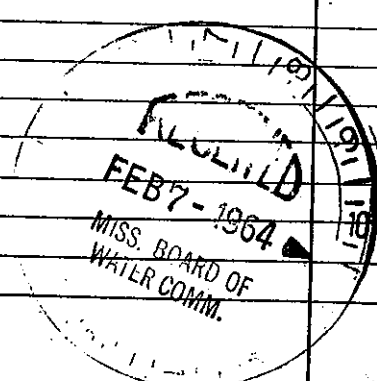

(Use Back Side)

Well No.

Mail this copy to Board of Water Commissioners 429 Miss. St. Jackson, Miss