

CLARKE MISSISSIPPI BOARD OF WATER COMMISSIONERS

B AS6
2-64

WATER WELL DRILLERS LOG

9

Date: Feb, 1964 Driller: Peoples Drilling Co., Clark
(Name)

(1) Owner of Land: <u>Ruffin</u> (Name) <u>Enterprise, Miss</u> (Address)	Description & Color of Materials Sand, Clay, Red Clay, Shell, etc.	Thick- ness Feet	Depth Feet
(2) Location: <u>24 1/4</u> Sec <u>14E</u> T. <u>R</u> <u>Town of Enterprise</u> miles of (Nearest Town)			
(3) Topography: <u>Flat</u> (Hilly) (Flat) (Level)			
(4) Purpose of Well: <u>Domestic</u> (Domestic Irrigation Municipal, Industrial, Other)			

Yellow sand	15	15
Sand Rock	6	21
Green Sand	14	35
Blue mud + Rock	112	147
Brown Sandy Shell	11	158
White Sand	22	180
White Sand + Brown		
Shell + Shell	20	200

Information upon completion of well:

(1) Diameter 4 inches.

(2) Total Depth 200 feet.

(3) Water Level 0 feet below top of ground.

(4) Cased to 42', Size 4"


(5) Screen: Size _____, Length _____.

(6) Were any formations sealed against pollution?
_____ yes, _____ no.

If YES depth of formation _____

Why _____

Drillers Remarks: Red water

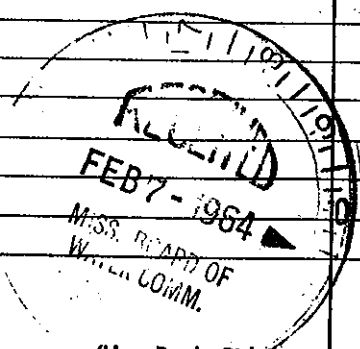

(Use Back Side)

Well No.

Mail this copy to Board of Water Commissioners 429 Miss. St. Jackson, Miss.