

CLARKE MISSISSIPPI BOARD OF WATER COMMISSIONERS

5 **BAS7**
9-25-64

WATER WELL DRILLERS LOG

Date: 9.25.1, 1964, Driller: M. Donald & Hill Inc e/lanke
 County: e/lanke

(Name)

(1) Owner of Land: <u>PEARL HUNTER</u> <small>(Name)</small> <u>ENTERPRISE, MISS</u> <small>(Address)</small>	Description & Color of Materials Sand, Clay, Red Clay, Shell, etc.	Thick- ness Feet	Depth Feet
	<u>CLAY ST SAND</u>	<u>0</u>	<u>35</u>
(2) Location: <u>2 1/4</u> <u>UN NE</u> <u>In Enterprise, MISS</u> <small>(distance) miles (direction) of (Nearest Town)</small>	<u>SHALE STRATA</u>	<u>35</u>	<u>70</u>
	<u>SHALE</u>	<u>70</u>	<u>120</u>
(3) Topography: <u>X</u> <small>(Hilly) (Flat) (Level)</small>	<u>SAND</u>	<u>120</u>	<u>132</u>
(4) Purpose of Well: <u>DOMESTIC</u> <small>(Domestic Irrigation Municipal, Industrial, Other)</small>			

Information upon completion of well:

(1) Diameter 3 1/2 inches. TEST HOLE

(2) Total Depth 132' feet.

(3) Water Level 20' feet below top of ground.

(4) Cased to 60', Size 4"


(5) Screen: Size _____, Length _____.

(6) Were any formations sealed against pollution?
 _____ yes, _____ no.

If YES depth of formation _____

Why _____

Drillers Remarks: _____

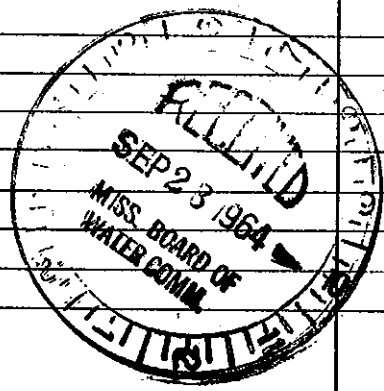

(Use Back Side)

Well No.

Mail this copy to Board of Water Commissioners 429 Miss. St. Jackson, Mis.