

CLARKE
 5 B A 59
 10-64

MISSISSIPPI BOARD OF WATER COMMISSIONERS

WATER WELL DRILLERS LOG


Date: Oct, 1964, Driller: Peeples Drilling Co County Clarke
 (Name)

(1) Owner of Land:	Description & Color of Materials Sand, Clay, Red Clay, Shell, etc.	Thick- ness Feet	Depth Feet
<u>Enterprise Laundry</u> (Name)	<u>Yellow Sand</u>	<u>35</u>	<u>35</u>
<u>Enterprise, Miss</u> (Address)	<u>Green Rock</u>	<u>17</u>	<u>52</u>
(2) Location: <u>1/4</u> , <u>1/4</u> , Sec <u>24</u> <u>4N 14E</u> T R	<u>Green Sand &</u>		
<u>Town of Enterprise</u> miles _____, of _____ (distance) (direction) (Nearest Town)	<u>Blue marl streak</u>	<u>11</u>	<u>63</u>
(3) Topography: <u>flat</u> (Hill) (Flat) (Level)	<u>Rock & Blue marl</u>	<u>37</u>	<u>100</u>
(4) Purpose of Well: <u>Laundry</u> (Domestic Irrigation, Municipal, Industrial, Other)	<u>White sand</u>	<u>6</u>	<u>106</u>
	<u>Hard Rock & Blue</u>		
	<u>marl stone</u>	<u>72</u>	<u>178</u>
	<u>Blue sandy shale</u>	<u>14</u>	<u>192</u>
	<u>White sand</u>	<u>29</u>	<u>221</u>

Information upon completion of well:

- (1) Diameter 4 inches.
- (2) Total Depth 221 feet.
- (3) Water Level 10 feet below top of ground.
- (4) Cased to 140', Size 4"
- (5) Screen: Size 2", Length 12'
- (6) Were any formations sealed against pollution?
 yes, no.

If YES depth of formation _____
 Why _____
 Drillers Remarks: _____

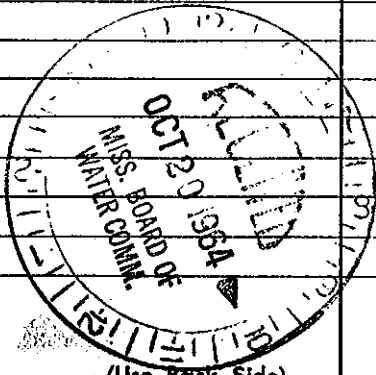

(Use Back Side)

Well No.

Mail this copy to Board of Water Commissioners 429 Miss. St. Jackson, Miss.