

**CLARKE** MISSISSIPPI BOARD OF WATER COMMISSIONERS

5 **B A 61**  
6-65

**WATER WELL DRILLERS LOG**


Date: June, 1965, Driller: Peoples Drilling Co County Clarke  
(Name)

(1) Owner of Land:	Description & Color of Materials Sand, Clay, Red Clay, Shell, etc.	Thick- ness Feet	Depth Feet
<u>Eugene Hunter</u> (Name) <u>Enterprise, Miss</u> (Address)	<u>Red sand &amp; sandy clay</u>	<u>27</u>	<u>27</u>
(2) Location: <u>1/4</u> , <u>1/4</u> , Sec. <u>24</u> <sup><u>4N 14E</u></sup> T. <u>4</u> R. <u>1</u>	<u>Blue marl</u>	<u>15</u>	<u>42</u>
<u>Town of Enterprise</u> miles of (distance) <u>7</u> (direction) <u>flat</u> (Flat) (Level) (Nearest Town)	<u>Blue marl &amp; rock</u>	<u>173</u>	<u>215</u>
(3) Topography: <u>Flat</u> (Hilly) (Flat) (Level)	<u>White sand shale</u>	<u>14</u>	<u>231</u>
(4) Purpose of Well: <u>Home</u> (Domestic Irrigation Municipal, Industrial, Other)	<u>stream</u>		

Information upon completion of well:

- (1) Diameter 4 inches.
- (2) Total Depth 231 feet.
- (3) Water Level 14 feet below top of ground.
- (4) Cased to 42', Size 4"
- (5) Screen: Size NONE, Length \_\_\_\_\_
- (6) Were any formations sealed against pollution?  
\_\_\_\_\_ yes, \_\_\_\_\_ no.

If YES depth of formation \_\_\_\_\_  
Why \_\_\_\_\_  
Drillers Remarks: \_\_\_\_\_

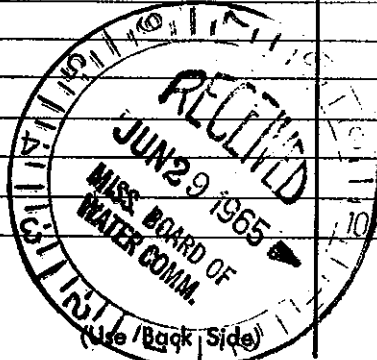

Well No. \_\_\_\_\_

Mail this copy to Board of Water Commissioners 429 Miss. St. Jackson, Ms