

CLARKE MISSISSIPPI BOARD OF WATER COMMISSIONERS

A62

5-15-64

WATER WELL DRILLERS LOG

Date: 5-15, 1964, Driller: Mc Donald + Hill County Lauderdale

(Name)

(1) Owner of Land: MANUELL TENDLE  
(Name)

ENTREPRISE-MISS.  
(Address)

(2) Location: 1/4, 1/4, Sec. 24 T 14 R 14

miles of  
(distance) (direction) (Nearest Town)

(3) Topography: FLAT  
(Hilly) (Flat) (Level)

(4) Purpose of Well: DOMESTIC  
(Domestic Irrigation  
Municipal, Industrial, Other)

Description & Color of Materials  
Sand, Clay, Red Clay, Shell, etc.

Thick-  
ness  
Feet

Depth  
Feet

Sandy Clay	0	10
e Sand	10	22
gravel	22	25
Black Shale	25	40
Brown Shale	40	60
Lime + Brown Rocks	60	75
Black Sand	75	85
Shale	85	87
Fine Sand	87	95
Shale	95	145
Sandy Str.	145	150


Information upon completion of well:

- (1) Diameter 4 inches.
- (2) Total Depth 150 feet.
- (3) Water Level 0 feet below top of ground.
- (4) Cased to 33 1/2, Size 4
- (5) Screen: Size, Length
- (6) Were any formations sealed against pollution?  
yes, no.

If YES depth of formation

Why

Drillers Remarks: Set Set  
30' 15' tail pipe

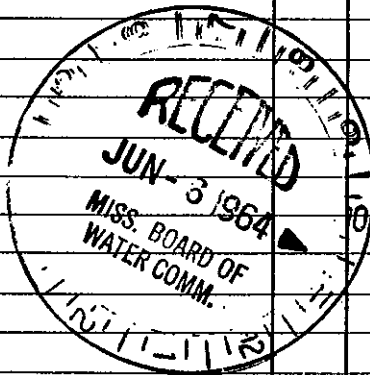

Well No.

(Use Back Side)

Mail this copy to Board of Water Commissioners 429 Miss. St. Jackson, Mis: