

CLARK MISSISSIPPI BOARD OF WATER COMMISSIONERS

EA 63
9-10-60

WATER WELL DRILLERS LOG


Date: 9/16, 1960, Driller: M. E. Donald & Hill Inc Clarke
(Name)

(1) Owner of Land: John W. Braun
(Name)
Enterprise
(Address)
(2) Location: 1/4, 1/4, Sec. 24 T. R. 4N 14E
miles of (distance) (direction) (Nearest Town)
(3) Topography: flat
(Hilly) (Flat) (Level)
(4) Purpose of Well: irrigation
(Domestic Irrigation, Municipal, Industrial, Other)

Description & Color of Materials Sand, Clay, Red Clay, Shell, etc.	Thick- ness Feet	Depth Feet
Clay	0	18
C. Sand	10	15
Black (mud) st	15	88
C. Sand	88	110
mud	110	125
C. Sand	125	160

Information upon completion of well:

(1) Diameter 4 inches.
(2) Total Depth 160 feet.
(3) Water Level flow feet below top of ground.
(4) Cased to 42 ft, Size 4 inch
(5) Screen: Size _____, Length _____
(6) Were any formations sealed against pollution?
yes, no.
If YES depth of formation 42

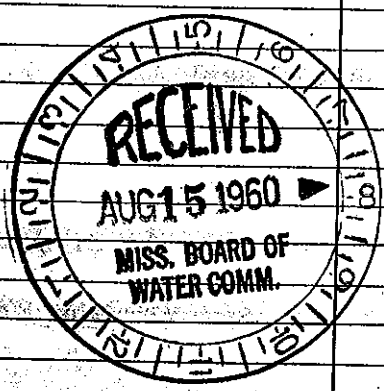

Why _____
Drillers Remarks: _____

Well No.

(Use Back Side)

Mail this copy to Board of Water Commissioners 429 Miss. St. Jackson, Miss.