

CLARKE MISSISSIPPI BOARD OF WATER COMMISSIONERS

AG4
5-19-64

WATER WELL DRILLERS LOG

Date: 5-19, 1964, Driller: MCDONALD HILL County LAUDLEY 2415
(Name)

(1) Owner of Land: SHELLY KING
(Name)
ENTREPRISE MISS
(Address)

(2) Location: 1/4, 1/4, Sec. 24 4 14
T R
miles of
(distance) (direction) (Nearest Town)

(3) Topography: FLAT
(Hilly) (Flat) (Level)

(4) Purpose of Well: DOMESTIC
(Domestic Irrigation
Municipal, Industrial, Other)

Description & Color of Materials Sand, Clay, Red Clay, Shell, etc.	Thick- ness Feet	Depth Feet
Clay	0	7
C Sand	7	16
Hard Rock	16	25
Shells in sand	25	33
Shale + S. str.	33	70
Lime + lime Rock	70	117
Sands	117	120
Lime + lime Rock	120	145
Soft Shale	145	157
C Sand	157	170

Information upon completion of well:

(1) Diameter 4 inches.

(2) Total Depth 170 feet.

(3) Water Level 12 feet below top of ground.

(4) Cased to 57, Size 4


(5) Screen: Size, Length

(6) Were any formations sealed against pollution?
yes, no.

If YES depth of formation

Why

Drillers Remarks: det get
about 40 ft

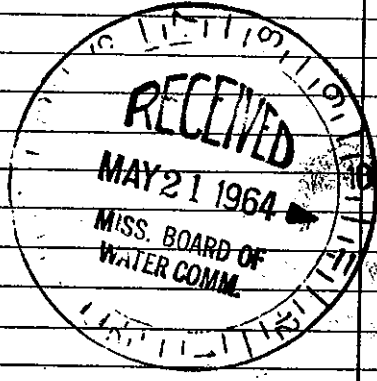

57- ft 4" Black
1- 4x12 ripples

Well No.

(Use Back Side)

Mail this copy to Board of Water Commissioners 429 Miss. St. Jackson, Mis.