

Clarke
A81
8-20-62

MISSISSIPPI BOARD OF WATER COMMISSIONERS

WATER WELL DRILLERS LOG

CODED
CODED


Date: 8-28, 1962, Driller: McDonald - Huerfano
(Name)

(1) Owner of Land: <u>H. C. Wallin</u> (Name) <u>Enterprise - Miss.</u> (Address)	Description & Color of Materials Sand, Clay, Red Clay, Shell, etc.	Thickness Feet	Depth Feet
		<u>0</u>	<u>20</u>
(2) Location: <u>23</u> <u>4N</u> <u>4E</u> <u>15</u> miles <u>SW</u> of <u>Meridian</u> (Distance) (direction) (Nearest Town)	<u>Shale</u>	<u>26</u>	<u>25</u>
	<u>Rock</u>	<u>25</u>	<u>32</u>
(3) Topography: _____ (Hilly) (Flat) (Level)	<u>M. shale</u>	<u>32</u>	<u>50</u>
	<u>H. shale</u>	<u>50</u>	<u>70</u>
(4) Purpose of Well: <u>Domestic</u> (Domestic Irrigation Municipal, Industrial, Other)	<u>Soft Shale</u>	<u>70</u>	<u>82</u>
	<u>M. sand</u>	<u>82</u>	<u>93</u>
	<u>Shale - Rock St.</u>	<u>93</u>	<u>130</u>

Information upon completion of well:

- (1) Diameter 4 inches.
- (2) Total Depth 130 feet.
- (3) Water Level 14 feet below top of ground.
- (4) Cased to 63, Size _____
- (5) Screen: Size _____, Length _____
- (6) Were any formations sealed against pollution?
_____ yes, no.

CODED

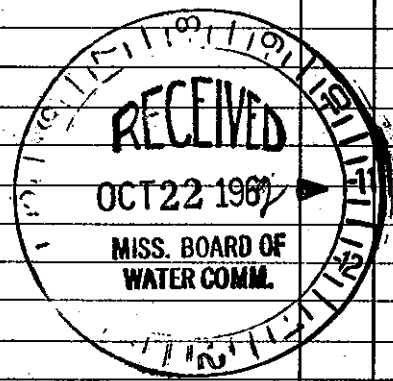

If YES depth of formation _____

Why _____

Drillers Remarks: _____

Well No. _____

(Use Back Side)

Mail this copy to Board of Water Commissioners 429 Miss. St. Jackson, Miss