

CLARKE  
A 90  
9-8-62

MISSISSIPPI BOARD OF WATER COMMISSIONERS

WATER WELL DRILLERS LOG

**CODED**

*Clarke*

Date: 9-8, 1962, Driller: McDonald-Hill County: Leflore  
(Name)


(1) Owner of Land: W.R. Johnson  
(Name)  
Wellb Sec. Sta. Enterprise  
(Address)  
(2) Location: 23 4N/4E  
1/4, 23 4N/4E  
1/4, Sec. 4 1  
X miles, of Enterprise  
(distance) (direction) (Nearest Town)  
(3) Topography:             
(Hilly) (Flat) (Level)  
(4) Purpose of Well: Domestic  
(Domestic Irrigation  
Municipal, Industrial, Other)

Description & Color of Materials Sand, Clay, Red Clay, Shell, etc.	Thick- ness Feet	Depth Feet
Clay	0	12
Shale	12	30
Bk. Shale	30	44
Clay	44	84
M Sand	84	95
C Sand	95	103
M Sand	103	120
Sof Sand	120	126
M Shale	126	129
H. Shale	129	136
C. Sand	136	145
M Sand	145	150

Information upon completion of well:

(1) Diameter 2 inches.  
(2) Total Depth 150 feet.  
(3) Water Level 60 feet below top of ground.  
(4) Cased to 137, Size 2"  
(5) Screen: Size 2, Length 5  
(6) Were any formations sealed against pollution?  
           yes,            no.  
If YES depth of formation             
Why             
Drillers Remarks:           

**CODED**

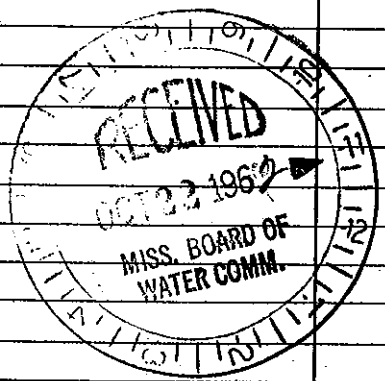

Well No.

(Use Back Side)

Mail this copy to Board of Water Commissioners 429 Miss. St. Jackson, Miss.