

CLARK MISSISSIPPI BOARD OF WATER COMMISSIONERS

OA 92  
9-12-60

WATER WELL DRILLERS LOG

**CODED**

Date: 7/12, 1960, Driller: Mr. Donald W. Hill, Inc. Clarke  
(Name)

(1) Owner of Land: Will Magee  
(Name)  
Enterprise mine  
(Address)


(2) Location: 1/4, 1/4, Sec. 23 T. 4 N. R. 14 E  
18 miles South of Minden  
(distance) (direction) (Nearest Town)

(3) Topography: flat  
(Hill) (Flat) (Level)

(4) Purpose of Well: Domestic  
(Domestic Irrigation, Municipal, Industrial, Other)

Description & Color of Materials Sand, Clay, Red Clay, Shell, etc.	Thick- ness Feet	Depth Feet
<u>Clay + Sand</u>	<u>0</u>	<u>17</u>
<u>marl</u>	<u>17</u>	<u>40</u>
<u>Rock + marl st</u>	<u>40</u>	<u>80</u>
<u>marl + sandy marl</u>	<u>80</u>	<u>113</u>
<u>Rock + C. Sand st.</u>	<u>113</u>	<u>130</u>

**CODED**

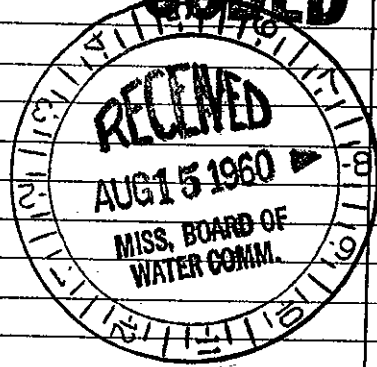

Information upon completion of well:

(1) Diameter 2 inches.

(2) Total Depth 130 feet.

(3) Water Level 25 feet below top of ground.

(4) Cased to 84, Size 2"

(5) Screen: Size \_\_\_\_\_, Length \_\_\_\_\_

(6) Were any formations sealed against pollution?  
\_\_\_\_\_ yes,  no.

If YES depth of formation \_\_\_\_\_

Why \_\_\_\_\_

Drillers Remarks: \_\_\_\_\_

Well No

(Use Back Side)

Mail this copy to Board of Water Commissioners 429 Miss. St. Jackson, Miss.