

MISSISSIPPI DEPARTMENT OF NATURAL RESOURCES

Bureau of Land and Water Resources

Southport Mall

P.O. Box 10631

Jackson, Mississippi 39209

WATER WELL DRILLERS LOG

Clucke
F 7010
AIAZ

11-30-84
date well completed

W. S. ...
firm name

... Co.
county well located

LANDOWNER:
Walter N Perry
...
(mailing address)

description of formations encountered	from	to
<u>clay</u>	<u>0</u>	<u>30</u>
<u>sand & clay</u>	<u>30</u>	<u>95</u>
<u>sandy shale</u>	<u>95</u>	<u>110</u>
<u>shale</u>	<u>110</u>	<u>124</u>
<u>Rock & shells</u>	<u>124</u>	<u>143</u>
<u>green sandstone</u>	<u>143</u>	<u>200</u>
<u>shale</u>		
<u>dark rock</u>	<u>200</u>	<u>263</u>
<u>shale & sand</u>	<u>263</u>	<u>300</u>
<u>...</u>	<u>300</u>	<u>...</u>

WELL LOCATION:
sec. 10 T. 3 S. R. 14 E.
2 miles (distance) NW (direction) of Enterprise (nearest town)

WELL PURPOSE:
...
(home, irrigation, municipal, industrial)

WELL COMPLETION DATA:
(1) diameter (inches) 11"
(2) total depth (feet) 320
(3) static water level (feet) 12 below above top of ground.
(4) casing Pvc 100' (material), 100' (depth)
... (size) if telescope see back.
(5) screen ... (length), ... (depth to top)
... (size), ... (material)
(6) pump 1/2 (HP), 800 (yield/gpm)
... (type power)
(7) electric log ... (yes or no)
... (organization running log)
(8) how well bottom plugged ...

DRILLERS REMARKS:
...


DEPT. OF NATURAL RESOURCES
BUREAU OF LAND & WATER RESOURCES

DEC - 4 1984

RECEIVED

If well telescopes please
sketch and show depths.

GROUND LEVEL

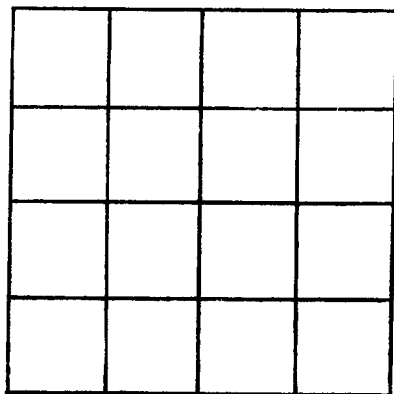

SECTION _____

Please indicate well location X.

ADDITIONAL INFORMATION

If more than one screen,
show locations of each on sketch.