


Clarke  
3 B 3  
7-66

MISSISSIPPI BOARD OF WATER COMMISSIONERS

WATER WELL DRILLERS LOG

Date: July, 1966, Driller: Peoples Drilling Co County Clarke  
(Name)

(1) Owner of Land:	Description & Color of Materials Sand, Clay, Red Clay, Shell, etc.	Thick- ness Feet	Depth Feet
<u>Jack Wells</u> (Name) <u>Stonewall, Miss</u> (Address)	<u>Yellow sandy clay</u> <u>&amp; sand streak</u>	<u>31</u>	<u>31</u>
(2) Location: <u>NE 1/4, NE 1/4, Sec. 33 T4 R6E</u>	<u>Yellow Sand +</u> <u>small clay streak</u>	<u>74</u>	<u>105</u>
<u>2</u> miles <u>E</u> , of <u>Stonewall</u> (distance) (direction) (Nearest Town)	<u>Gray shale</u> <u>Blue marl + rocks</u>	<u>10</u>	<u>115</u>
(3) Topography: <u>Hilly</u> (Hilly) (Ft) (Level)	<u>streak</u> <u>Green sand + Blue</u>	<u>53</u>	<u>168</u>
(4) Purpose of Well: <u>Home</u> (Domestic Irrigation Municipal, Industrial, Other)	<u>marl streak</u>	<u>12</u>	<u>180</u>
	<u>Blue marl + rocks</u>	<u>100</u>	<u>280</u>
	<u>Gray sandy shale</u>	<u>21</u>	<u>301</u>
	<u>White sand + small</u> <u>shale streak</u>	<u>24</u>	<u>325</u>
Information upon completion of well:			
(1) Diameter <u>4</u> inches.			
(2) Total Depth <u>325</u> feet.			
(3) Water Level <u>92</u> feet below top of ground.			
(4) Cased to <u>126'</u> , Size <u>4"</u>			
(5) Screen: Size <u>NONE</u> , Length _____			
(6) Were any formations sealed against pollution? <input checked="" type="checkbox"/> yes, <input type="checkbox"/> no.			
If YES depth of formation _____			
Why _____			
Drillers Remarks: _____			
_____			
_____			
_____			

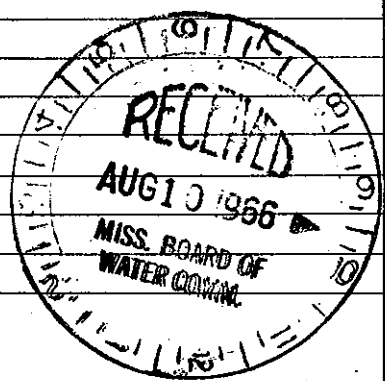

(Use Back Side)

Well No.

Mail this copy to Board of Water Commissioners 429 Miss. St. Jackson. Miss.