

Clarke  
 3 B 4  
 3-67

MISSISSIPPI  
 BOARD OF WATER COMMISSIONERS  
 416 North State Street  
 Jackson, Mississippi 39201

WATER WELL DRILLERS LOG

3-24-67 19 McDonald + Hill CLARK  
 date well completed firm name county well located

LANDOWNER: BETTY BROWN

STONEWALL

(mailing address)

WELL LOCATION:


sec. 35 T 4 N R 15 E  
 S W  
 3 1/2 miles NEAST of STONEWALL  
 (distance) (direction) (nearest town)

WELL PURPOSE: None  
 (home, irrigation, municipal, industrial)

WELL COMPLETION DATA:

- (1) diameter (inches) 3 7/8 TEST HOLE
- (2) total depth (feet) 320'
- (3) static water level (feet) 120' below above top of ground.
- (4) casing GALV 160'  
 (material) (depth)  
 NO If telescope see back.  
 (size)
- (5) screen NO NO  
 (length) (depth to top)  
 NO NO  
 (size) (material)
- (6) pump 1/2 HP PUMP 5  
 (HP) (yield gpm)  
 230  
 (type power)
- (7) electric log NO  
 (yes or no)  
 (organization running log)
- (8) how well bottom plugged OPEN

| description of formations encountered | from | to  |
|---------------------------------------|------|-----|
| CLAY                                  | 0    | 18  |
| SAND                                  | 18   | 80  |
| SHALE                                 | 80   | 86  |
| SAND                                  | 86   | 92  |
| SHALE                                 | 92   | 110 |
| SHALE ST. ROCK                        | 110  | 125 |
| SAND                                  | 125  | 145 |
| ROCK ST. SHALE                        | 145  | 260 |
| SHALE                                 | 260  | 290 |
| SAND                                  | 290  | 320 |

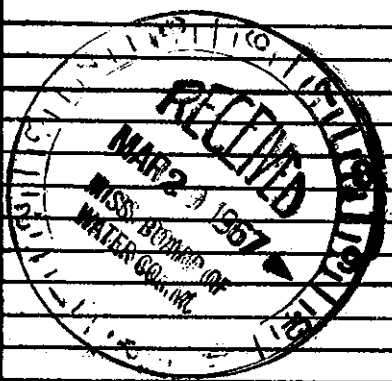

DRILLERS REMARKS: