

Clarke
 87
 8-67

MISSISSIPPI
 BOARD OF WATER COMMISSIONERS
 416 North State Street
 Jackson, Mississippi 39201

WATER WELL DRILLERS LOG

Aug. 1967 Reeper Drilling Co. Clarke
 date well completed firm name county well located

LANDOWNER: Wm. Heinrich

Stonewall, Miss.

(mailing address)

WELL LOCATION:

sec. 32 T. 4 N. R. 15 E. S. W.
 1/2 miles N.E. of Stonewall
 (distance) (direction) (nearest town)

WELL PURPOSE: Home
 (home, irrigation, municipal, industrial)


WELL COMPLETION DATA:

- (1) diameter (inches) 4"
- (2) total depth (feet) 294
- (3) static water level (feet) 35 below top of ground.
- (4) casing Iron 147' (material) (depth)
 4" (size) if telescope see back.
- (5) screen NONE (length) (depth to top)
 (size) (material)
- (6) pump 1/2 (HP) 12 (yield gpm)
 electric (type power)
- (7) electric log NO (yes or no)
 (organization running log)
- (8) how well bottom plugged open

description of formations encountered

from to

Yellow Sandy Clay	0	12
Yellow Sand + small Clay streaks	12	43
Blue Sandy Slale	63	84
Blue Marl + Rock	84	128
Green Sand	128	140
Blue Marl + Rock	140	235
Gray Sandy Slale + small white Sand streaks	235	268
White Sand	268	294

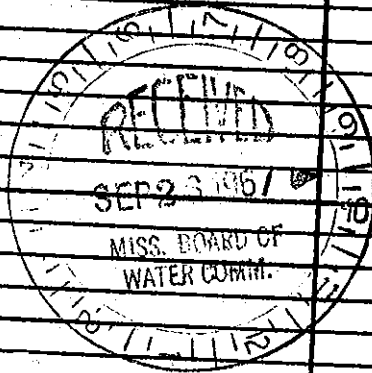

DRILLERS REMARKS: