

P

Clarke
 5 B10
 9-67

MISSISSIPPI
 BOARD OF WATER COMMISSIONERS
 416 North State Street
 Jackson, Mississippi 39201

WATER WELL DRILLERS LOG

Sept. 1967 Peoples Drilling Co. Clarke
 date well completed firm name county well located


LANDOWNER: Harry Myers Stonewall, Miss. (mailing address)	description of formations encountered	from	to
	red sandy clay	0	21
	yellow sand	21	63
	grey sandy shale	63	80
	blue marl + rock	80	105
	green sand + chert	105	122
	blue marl + rock	122	235
	grey sandy shale	235	252
	grey sandy shale + sand + streaks	252	275
	white sand	275	294

WELL LOCATION:
 sec. 34 T. 4 N. R. 15 E.
 3 1/2 miles N.E. of Stonewall
 (distance) (direction) (nearest town)

WELL PURPOSE: home
 (home, irrigation, municipal, industrial)

WELL COMPLETION DATA:

(1) diameter (inches) 4
 (2) total depth (feet) 294
 (3) static water level (feet) 58 below top of ground.
 (4) casing iron, 126', (material) (depth)
 4" (size) if telescope see back.
 (5) screen none (length) (depth to top)
 (6) pump 1/2 (HP) 12 (material) (yield gpm)
 electric (type power)
 (7) electric log no. (yes or no)
 (organization running log)
 (8) how well bottom plugged open

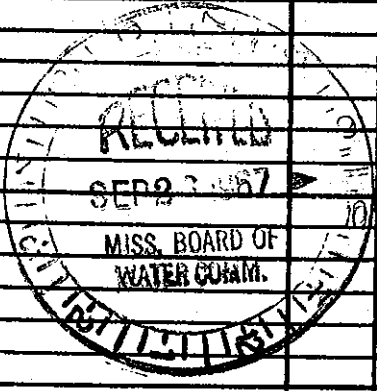

DRILLERS REMARKS: