

Clarke
S B16
9-66

MISSISSIPPI BOARD OF WATER COMMISSIONERS

P

WATER WELL DRILLERS LOG

Date: Sept, 1966, Driller: Peeples Drilling Co County Clarke.
(Name)

(1) Owner of Land: Walter Boyd
(Name)
Enterprise, Miss.
(Address)

(2) Location: NW 1/4, NW 1/4, Sec. 19 T41N R5E
1/2 miles N of Enterprise
(distance) (direction) (Nearest Town)

(3) Topography: Flat
(Hilly) (Flat) (Level)

(4) Purpose of Well: Cattle
(Domestic Irrigation
Municipal, Industrial, Other)

| Description & Color of Materials Sand, Clay, Red Clay, Shell, etc. | Thick- ness Feet | Depth Feet |
|-----------------------------------------------------------------------|------------------------|---------------|
| <u>White sand</u> | <u>14</u> | <u>14</u> |
| <u>Blue sand rock + marl</u> | <u>11</u> | <u>25</u> |
| <u>Rock + Blue marl</u> | <u>9</u> | <u>34</u> |
| <u>Blue clay</u> | <u>6</u> | <u>40</u> |
| <u>White sand</u> | <u>19</u> | <u>59</u> |
| <u>Brown clay</u> | <u>2</u> | <u>61</u> |

Information upon completion of well:

(1) Diameter 4 inches.

(2) Total Depth 147 feet.

(3) Water Level 7.5 feet below top of ground.

(4) Cased to 42', Size 4"


(5) Screen: Size NONE, Length _____

(6) Were any formations sealed against pollution?
 yes, _____ no.

If YES depth of formation 14'

Why Possible surface contamination

Drillers Remarks: _____

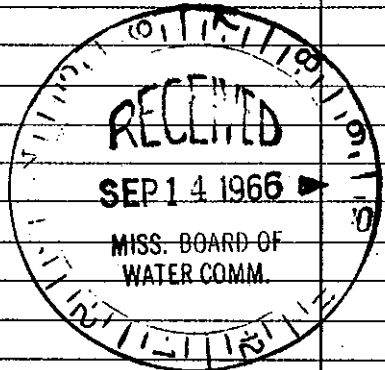

Well No.

(Use Back Side)

Mail this copy to Board of Water Commissioners 429 Miss. St. Jackson, Miss