

MISSISSIPPI BOARD OF WATER COMMISSIONERS

C. CLARKE

WATER WELL DRILLERS LOG

5 B 17

11-9-60

Date: Nov. 9, 1960, Driller: Perry Drilling Co County Lauderdale

(Name)

| (1) Owner of Land  | Description & Color of Materials<br>Sand, Clay, Red Clay, Shell, etc. | Thick-<br>ness<br>Feet | Depth<br>Feet |
|--|---|------------------------|---------------|
| <u>Enterprise Colored School</u><br>(Name)   | <u>Light clay + sand</u>  | 0                      | 22'           |
| <u>Enterprise, Miss.</u><br>(Address)  | <u>Layers Rock + sand</u>   | 22'                    | 44'           |
| (2) Location: <u>30</u> <u>4N-15E</u>  | <u>'J' Rock + mud</u>   | 44'                    | 168'          |
| <u>1/4</u> miles <u>South East</u> of <u>Enterprise</u><br>(distance) (direction) (Nearest Town) | <u>Mud and sand</u>   | 168'                   | 178'          |
| (3) Topography: <u>Flat</u><br>(Hilly) (Flat) (Level)  | <u>sand with thin layers of dirt</u>                                  | 178'                   | 237           |
| (4) Purpose of Well: <u>School</u><br>(Domestic Irrigation<br>Municipal, Industrial, Other)      |   |                        |               |

Information upon completion of well:

(1) Diameter 4 inches.

(2) Total Depth 237 feet.

(3) Water Level 18 feet below top of ground.

(4) Cased to 168', Size 4"

(5) Screen: Size 2 1/4", Length 50'


(6) Were any formations sealed against pollution?  
 yes,  no.

If YES depth of formation 170'

blank 2 1/2" pipe between  
strainers

Why Surface casing set in

Drillers Remarks:

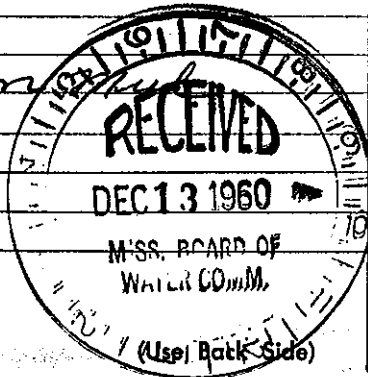

Well No.

Retain this copy for your office files.

**MISSISSIPPI DEPARTMENT OF ENVIRONMENTAL QUALITY**  
 Office of Land and Water Resources  
 P. O. Box 2309  
 Jackson, MS 39225  
**Water Well Plugging/Decommissioning Form**  
 OLWR-DF-1 (04/08)

|   |   |
|---|---|
| COUNTY WELL LOCATED: Clarke   | WELL NUMBER: B17  |
| PERMIT NUMBER:  | DATE WELL PLUGGED: 12/22/14   |
| NAME OF FIRM PLUGGING WELL: Walker-Hill Environmental   | TELEPHONE NUMBER: 601-736-3500  |
| NAME AND ADDRESS OF CURRENT LANDOWNER: Enterprise School Dist, 501 Short St. Enterprise, MS 39330 |   |
| WELL LOCATION: SECTION: 30 TOWNSHIP: 4N RANGE: 15E  |   |
| WELL LOCATION: LATITUDE: 32° 09' 49" LONGITUDE: 88° 48' 25"                                       | METHOD (CIRCLE ONE): <u>(1) USGS QUAD</u> (2) CONVENTIONAL SURVEY (3) GPS - HAND HELD OR SURVEY GRADE |
| DISTANCE: 1 mile DIRECTION: SE NEAREST TOWN: Enterprise OTHER LANDMARK:                           |   |
| WELL PURPOSE (HOME, IRRIGATION, MUNICIPAL, ETC.):   | Supply for School   |
| NAME OF WELL CONTRACTOR WHO DRILLED THE WELL:   | Unknown   |
| NAME OF LANDOWNER WHEN WELL WAS DRILLED:  | Enterprise School   |

| WELL DATA                                       |                           |                       |  |
|---|---------------------------|-----------------------|--|
| WELL DEPTH: 237                                 | HOLE DEPTH:               |                       |  |
| CASING DIAMETER (IN.): 4                        | CASING LENGTH (FT.): 168  | TYPE OF CASING: Steel |  |
| DEPTH TO STATIC WATER LEVEL: 70                 | DATE WELL COMPLETED: 9/60 |                       |  |
| WHY IS THE WELL BEING ABANDONED? out of Service |                           |                       |  |

DESCRIBE HOW THE WELL OR HOLE WAS PLUGGED (AMOUNT OF CASING AND/OR SCREEN THAT WAS REMOVED OR LEFT IN HOLE, MATERIAL AND AMOUNT USED IN PLUGGING, METHOD OF PLACING MATERIAL, ETC.)

Pulled out the pump. trimie grout in-place with cement/bentonite grout slurry from bottom to top by trimie method. Cut well casing 2.5' below ground surface

I CERTIFY THAT THE WELL WAS PLUGGED OR ABANDONED IN ACCORDANCE WITH THE STATE OF MISSISSIPPI REGULATIONS.

Daren S. Bracey

PRINT NAME

Daren S. Bracey


SIGNATURE

0-522

MS LICENSE NUMBER

1/10/15

DATE

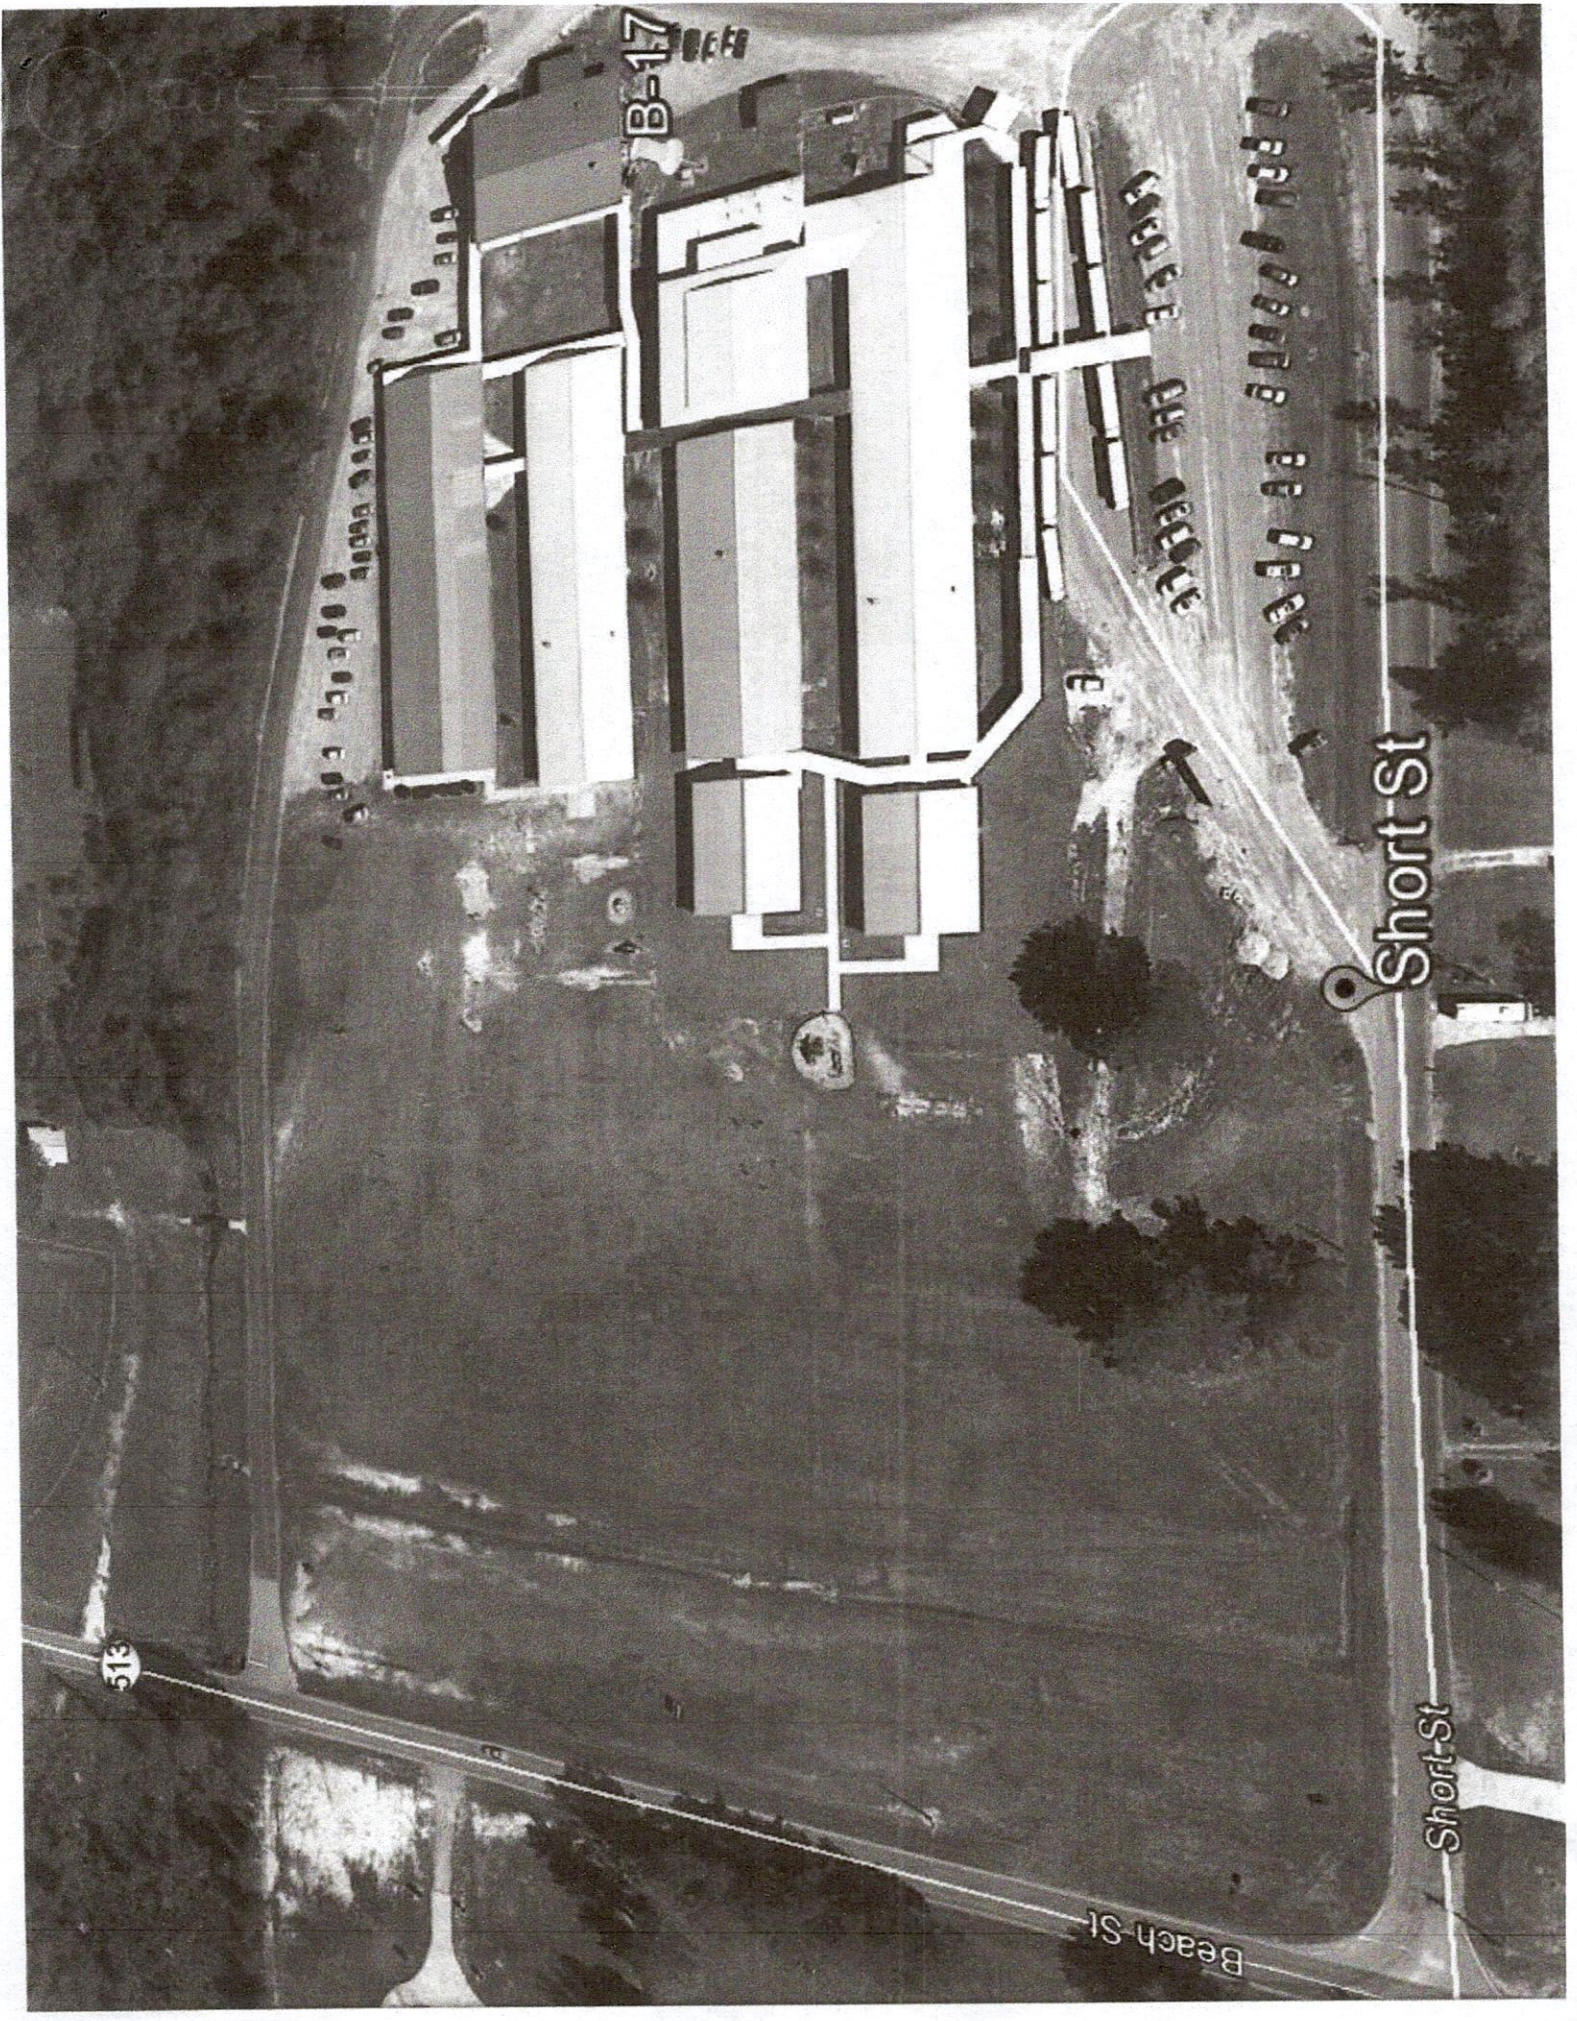

B-17

CHURCH OF THE GOOD SHEPHERD

1000 W. 1000 N.

Short St

Short St

Beach St

516