


5 B19  
8-62

8

WATER WELL DRILLERS LOG

Date: Aug 19 1962, Driller: Peoples & Rutledge County, Clarke  
(Name)

(1) Owner of Land: Neville Smith (Name)	Description & Color of Materials Sand, Clay, Red Clay, Shell, etc.	Thick- ness Feet	Depth Feet
Enterprise, Miss (Address)	Top soil to Red sand	12	12
(2) Location: 1/4, 1/4, Sec. T R	Green sand rock	4	16
Town of Enterprise 1/4 miles East of River (distance) (direction) (Nearest Town)	Green sand	12	28
(3) Topography: Flat (Hilly) (Flat) (Level)	Blue shale	10	38
(4) Purpose of Well: Domestic (Domestic Irrigation Municipal, Industrial, Other)	Blue shale & green rock streaks	99	136
Information upon completion of well:	Brown sandy shale	15	151
(1) Diameter 4 inches.	White sand	24	175
(2) Total Depth <del>346</del> 346 feet.	Brown sandy shale & sand streaks	24	199
(3) Water Level Flow feet below top of ground.	Gray shale & gumbo	105	284
(4) Cased to 42", Size 4"	Gray sandy shale & small sand streaks	41	325
(5) Screen: Size NONE, Length	Gray sand & small shale streaks	14	341
(6) Were any formations sealed against pollution? yes, no.	Brown shale	5	346
If YES depth of formation 28			
Why River bottom sand shale			
Drillers Remarks: approx 12 GPM FLOW			

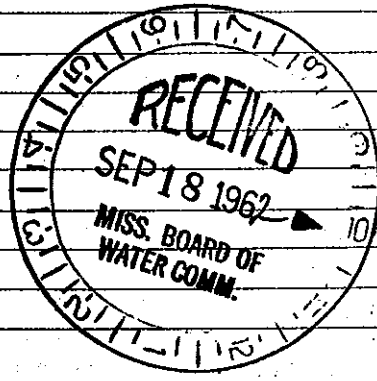

(Use Back Side)

Well No.