

Clarke
S B20
8-66

MISSISSIPPI BOARD OF WATER COMMISSIONERS

P

WATER WELL DRILLERS LOG

Date: Aug., 1966, Driller: Reeflex Drilling Co County Clarke
(Name)

(1) Owner of Land: <u>Clarence Hays</u> (Name)	Description & Color of Materials Sand, Clay, Red Clay, Shell, etc.	Thick- ness Feet	Depth Feet
<u>BAYLI Stonewall</u> (Address)	<u>Yellow Sandy clay +</u>		
(2) Location: <u>NE 1/4, NE 1/4, Sec. 33 T4R15,</u>	<u>Yellow Sand + shell</u>	<u>42</u>	<u>42</u>
<u>5</u> miles <u>E</u> , of <u>Stonewall</u> (distance) (direction) (Nearest Town)	<u>Yellow S. + shell</u>	<u>21</u>	<u>63</u>
(3) Topography: <u>Hilly</u> (Hilly) (Flat) (Level)	<u>Yellow Sand</u>	<u>39</u>	<u>102</u>
(4) Purpose of Well: <u>Home</u> (Domestic Irrigation Municipal, Industrial, Other)	<u>Blue marl</u>	<u>23</u>	<u>125</u>
	<u>Blue rock + Blue Marl</u>	<u>145</u>	<u>270</u>
	<u>Gray sandy shale</u>	<u>10</u>	<u>280</u>
	<u>White sand + small</u>		
	<u>gray shale streak</u>	<u>45</u>	<u>325</u>


Information upon completion of well:

- (1) Diameter 4 inches.
- (2) Total Depth 325 feet.
- (3) Water Level 93 feet below top of ground.
- (4) Cased to 124', Size 4"
- (5) Screen: Size NONE, Length _____
- (6) Were any formations sealed against pollution?
_____ yes, _____ no.

If YES depth of formation _____

Why _____

Drillers Remarks: _____

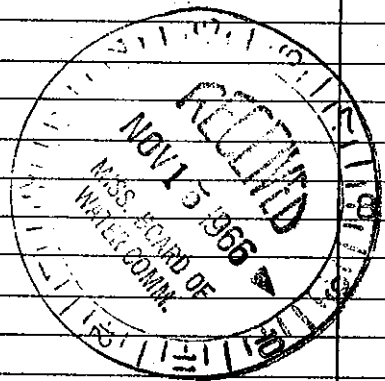

Well No.

(Use Back Side)

Copy to Board of Water Commissioners 429 Miss. St. Jackson, Miss.