

**CLARKE MISSISSIPPI BOARD OF WATER COMMISSIONERS**

**WATER WELL DRILLERS LOG**

Date: July, 1964, Driller: Peeples Drilling Co, County Clarke  
(Name)

(1) Owner of Land: Lee  
(Name)  
Entwistle, Miss  
(Address)  
 (2) Location: 1/4, 1/4, Sec. 19 <sup>4N 15E</sup> T. R.  
1/2 miles E, of Entwistle  
(distance) (direction) (Nearest Town)  
 (3) Topography: Flat to Hilly  
(Hilly) (Flat) (Level)  
 (4) Purpose of Well: Home  
(Domestic Irrigation Municipal, Industrial, Other)

Description & Color of Materials Sand, Clay, Red Clay, Shell, etc.	Thick- ness Feet	Depth Feet
<u>White sand</u>	<u>12</u>	<u>12</u>
<u>Sand Rock</u>	<u>9</u>	<u>21</u>
<u>Blue marl + rock</u>	<u>7</u>	<u>28</u>
<u>Green sand + chert</u>	<u>15</u>	<u>43</u>
<u>Blue marl + rock</u>	<u>109</u>	<u>152</u>
<u>Blue shale</u>	<u>8</u>	<u>160</u>
<u>White sand</u>	<u>20</u>	<u>180</u>


Information upon completion of well:

(1) Diameter: 4 inches.  
 (2) Total Depth: 180 feet.  
 (3) Water Level: 13 feet below top of ground.  
 (4) Cased to: 63', Size: 4"  
 (5) Screen: Size None, Length \_\_\_\_\_  
 (6) Were any formations sealed against pollution?  
 \_\_\_\_\_ yes, \_\_\_\_\_ no.

If YES depth of formation \_\_\_\_\_

Why \_\_\_\_\_

Drillers Remarks: Red water

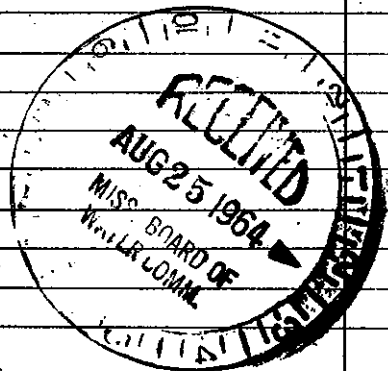

(Use Back Side)

Well No.

Mail this copy to Board of Water Commissioners 429 Miss. St. Jackson, Miss.