

CLARKE MISSISSIPPI BOARD OF WATER COMMISSIONERS


WATER WELL DRILLERS LOG

B22
7-14-60

B300 P

Date: 7-14, 1960, Driller: Peoples of Rockledge County, Clarke
(Name)

(1) Owner of Land: <u>E. R. Leppert H.</u> (Name)	Description & Color of Materials Sand, Clay, Red Clay, Shell, etc.	Thick- ness Feet	Depth Feet
<u>Enterprise Miss.</u> (Address)	<u>Red Sandy Clay</u>	18	18
(2) Location: <u>1/4</u> , <u>1/4</u> , Sec. <u>14 4 N 15 E</u> , T. <u>R.</u>	<u>Red Sand Rock</u>	18	20
<u>IN TOWN: East Enterprise</u> (distance) (direction) (Nearest Town)	<u>Hard Sandstone Rock</u>	11	31
(3) Topography: <u>Hilly</u> (Hilly) (Flat) (Level)	<u>Green Sand.</u>	17	48
(4) Purpose of Well: <u>Domestic</u> (Domestic Irrigation Municipal, Industrial, Other)	<u>Blue Rock & Shale.</u>	48	157
Information upon completion of well:		<u>214</u>	<u>201</u>
(1) Diameter _____ inches.			
(2) Total Depth _____ feet.			
(3) Water Level _____ feet below top of ground.			
(4) Cased to _____, Size _____.			
(5) Screen: Size _____, Length _____.			
(6) Were any formations sealed against pollution? _____ yes, _____ no.			
If YES depth of formation _____.			
Why _____.			
Drillers Remarks: _____			

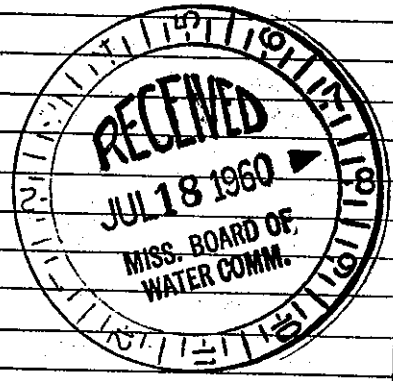

Well No.

(Use Back Side)

Mail this copy to Board of Water Commissioners 429 Miss. St. Jackson, Miss