

CLARKE MISSISSIPPI BOARD OF WATER COMMISSIONERS

B 23

WATER WELL DRILLERS LOG

5-7-62

Date: 5-7, 1962, Driller: McDonald Hill County Landmark
(Name)


(1) Owner of Land: J.R. Hammill
(Name)
Stone wall, Miss
(Address)
4N 15E
(2) Location: 1/4, 1/4, Sec. 31 T R
1 miles north of Stumwall
(distance) (direction) (Nearest Town)
(3) Topography: (Level)
(4) Purpose of Well: Domestic
(Domestic Irrigation, Municipal, Industrial, Other)

Description & Color of Materials Sand, Clay, Red Clay, Shell, etc.	Thick- ness Feet	Depth Feet
Clay	0	10
Sand & clay	10	40
Sand	40	65
Shale	65	75
Sand	75	84

Information upon completion of well:

(1) Diameter 2 inches.
(2) Total Depth 90' feet.
(3) Water Level 48 feet below top of ground.
(4) Cased to 84, Size 2"
(5) Screen: Size 2", Length 5
(6) Were any formations sealed against pollution?
yes, no.

If YES depth of formation _____
Why _____
Drillers Remarks: _____

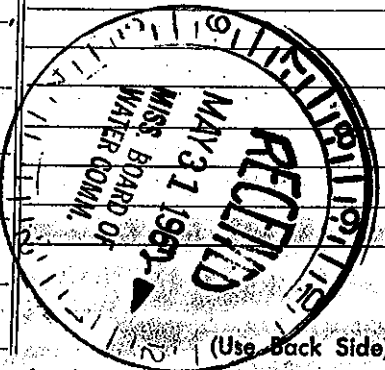

Well No.

Mail this copy to Board of Water Commissioners 429 Miss. St. Jackson, Miss.