

CLARKE
B 25

WATER WELL DRILLERS LOG

Date: 5-14-65, 1965, Driller: Bob Williamson County Clark
(Name)

(1) Owner of Land: Charlie Long
(Name)
Enterprise, Miss.
(Address)
(2) Location: 1/4, 1/4, Sec 20 4N 15E T R
(distance) (direction) (Nearest Town)
2 miles East, of Enterprise
(3) Topography: flat
(Hilly) (Flat) (Level)
(4) Purpose of Well: domestic
(Domestic Irrigation
Municipal, Industrial, Other)

Description & Color of Materials Sand, Clay, Red Clay, Shell, etc.	Thick- ness Feet	Depth Feet
<u>Red Clay</u>	<u>5</u>	<u>1-5</u>
<u>White sand</u>	<u>20</u>	<u>5-25</u>
<u>Rock & shell</u>	<u>195</u>	<u>25-220</u>
<u>sand</u>	<u>20</u>	<u>230-240</u>


Information upon completion of well:

(1) Diameter 4 inches.
(2) Total Depth 240 feet.
(3) Water Level 7 feet below top of ground.
(4) Cased to 40, Size 4"
(5) Screen: Size 0, Length _____
(6) Were any formations sealed against pollution?
 yes, _____ no.

If YES depth of formation _____

Why surface water

Drillers Remarks: _____

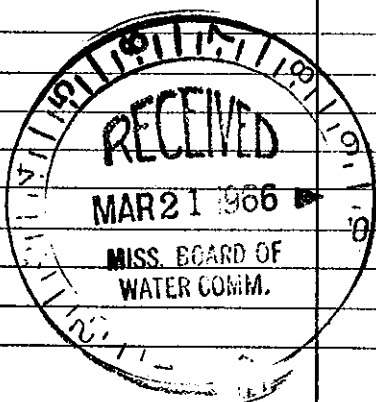

(Use Back Side)

Well No. _____

tain this copy for your office files.