

5 B 26

WATER WELL DRILLERS LOG

Date: 6-14-65, 1965, Drilled by McDonald & Hill, County Lauderdale  
(Name)

(1) Owner of Land: Mrs. Alma Martin  
(Name)

Rt. # 1 Quitman, Miss.  
(Address)

(2) Location: 1/4, 1/4, Sec. 28 T 4N R 15E

2 miles N-East of Stonewall  
(distance) (direction) (Nearest Town)

(3) Topography:  (Hilly)  (Flat)  (Level)

(4) Purpose of Well: Domestic  
(Domestic Irrigation, Municipal, Industrial, Other)

Description & Color of Materials Sand, Clay, Red Clay, Shell, etc.	Thick- ness Feet	Depth Feet
Clay & sand	0	10
H. shale	10	45
Bk. sandy shale	45	51
H. shale	57	71
lime rock dr.	71	96
H. shale	96	103
lime rock Bk. shale	103	110
Sandy str.	110	113
shale & rock str.	113	208
Sandy shale	208	223
Clay	223	247


Information Upon completion of well:

- (1) Diameter 4 inches.
- (2) Total Depth 250 feet.
- (3) Water Level 34 feet below top of ground.
- (4) Cased to 115, Size 4
- (5) Screen: Size \_\_\_\_\_, Length \_\_\_\_\_
- (6) Were any formations sealed against pollution?  
\_\_\_\_\_ yes,  no.

If YES depth of formation \_\_\_\_\_

Why \_\_\_\_\_

Drillers Remarks: \_\_\_\_\_

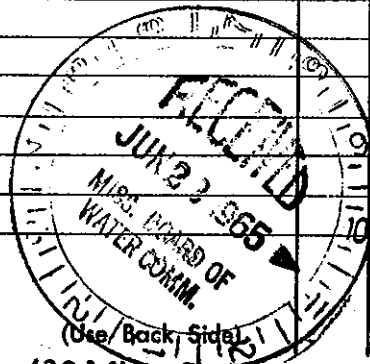

Well No. \_\_\_\_\_