

CLARK WATER WELL DRILLERS LOG

Date: June 6-65, 1965, Driller: Peoples Drilling Co County Clarke
 (Name)

(1) Owner of Land: <u>Ray Owens</u> <small>(Name)</small>	Description & Color of Materials Sand, Clay, Red Clay, Shell, etc.	Thick- ness Feet	Depth Feet
<u>Enterprise, Miss</u> <small>(Address)</small>	<u>yellow sand</u>		
(2) Location: <u>1/4</u> , <u>1/4</u> , Sec. <u>31</u> <u>4N 15E</u> T. R.	<u>sandy clay</u>	<u>120</u>	<u>120</u>
<u>2</u> miles <u>S</u> of <u>Enterprise</u> <small>(distance) (direction) (Nearest town)</small>	<u>blue marl</u>	<u>21</u>	<u>147</u>
(3) Topography: <u>Flat to Hilly</u> <small>(Hilly) (Flat) (Level)</small>	<u>Rock + marl</u>	<u>153</u>	<u>300</u>
(4) Purpose of Well: <u>Home</u> <small>(Domestic Irrigation Municipal, Industrial, Other)</small>	<u>White sand</u>		
	<u>Brown streak sand</u>	<u>30</u>	<u>330</u>
	<u>gray shale + sandy shale</u>	<u>48</u>	<u>378</u>

Information upon completion of well:

(1) Diameter 4 inches.

(2) Total Depth 378 feet.

(3) Water Level 45 feet below top of ground.

(4) Cased to 147', Size 4"


(5) Screen: Size NONE, Length _____.

(6) Were any formations sealed against pollution?
 _____ yes, _____ no.

If YES depth of formation _____

Why _____

Drillers Remarks: _____

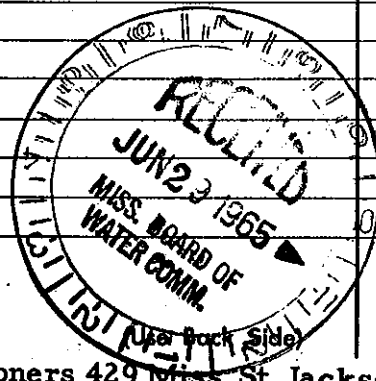

Well No.

Mail this copy to Board of Water Commissioners 429 Miss. St. Jackson, Miss: