

**CLARKE MISSISSIPPI BOARD OF WATER COMMISSIONERS**

5 **B30**

**6-25-64**

**WATER WELL DRILLERS LOG**

Date: 6-25, 1964, Driller: M. E. Donald of Hill June County Clarke  
(Name)

(1) Owner of Land: Billy Munnay  
(Name)  
Enterprise, Miss  
(Address)

(2) Location: 1/4, 1/4, Sec. 31 4115E  
(distance) (direction) (Nearest Town)

(3) Topography:  (Hilly)  (Flat)  (Level)

(4) Purpose of Well: Domestic  
(Domestic Irrigation, Municipal, Industrial, Other)

Description & Color of Materials Sand, Clay, Red Clay, Shell, etc.	Thick- ness Feet	Depth Feet
<u>Chad Sand</u>	<u>0</u>	<u>30</u>
<u>Shale</u>	<u>30</u>	<u>60</u>
<u>Rock &amp; St. Shale</u>	<u>60</u>	<u>210</u>
<u>Sand</u>	<u>210</u>	<u>230</u>

**Information upon completion of well:**

(1) Diameter 4" inches.

(2) Total Depth 230 feet.

(3) Water Level 13' feet below top of ground.

(4) Cased to 67, Size 4"


(5) Screen: Size none, Length \_\_\_\_\_

(6) Were any formations sealed against pollution?  
 \_\_\_\_\_ yes,  no.

If YES depth of formation \_\_\_\_\_

Why \_\_\_\_\_

Drillers Remarks: \_\_\_\_\_

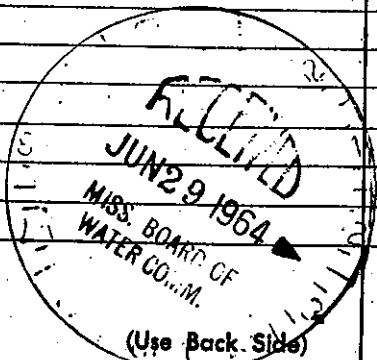

Well No. \_\_\_\_\_

Mail this copy to Board of Water Commissioners 429 Miss. St. Jackson, Miss.