

CLARKE MISSISSIPPI BOARD OF WATER COMMISSIONERS

B32

WATER WELL DRILLERS LOG


2-12-64

CODED

Date: 2-12, 1964, Driller: McDonald County Clarke

MALPUS

(Name)

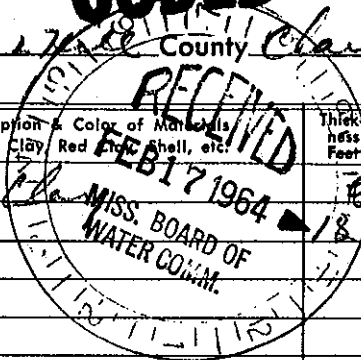

(1) Owner of Land: Thomas Malpus
(Name)
Rt. #1, Malpus, Ark
(Address)

Description & Color of Materials Sand, Clay, Red, etc. Shell, etc.	Thickness Feet	Depth Feet
<u>Sandy Clay</u>	<u>18</u>	<u>18</u>
<u>Sand</u>	<u>18</u>	<u>36</u>

(2) Location: $\frac{1}{4}$, $\frac{1}{4}$, Sec. 5 4N 15E T. R.
11 miles S, of Meridian
(distance) (direction) (Nearest Town)

(3) Topography: Hilly
(Hilly) (Flat) (Level)

(4) Purpose of Well: Domestic
(Domestic Irrigation, Municipal, Industrial, Other)

Information upon completion of well:

(1) Diameter 2 inches.

(2) Total Depth 68 feet.

(3) Water Level 63 feet below top of ground.

(4) Cased to 63, Size 2"

(5) Screen: Size _____, Length _____

(6) Were any formations sealed against pollution?

_____ yes, _____ no.

If YES depth of formation _____

Why _____

Drillers Remarks: _____

CODED

Well No.

(Use Back Side)

Mail this copy to Board of Water Commissioners 429 Miss. St. Jackson, Miss.