

CLARKE MISSISSIPPI BOARD OF WATER COMMISSIONERS

5 B33

P

2-4-64

WATER WELL DRILLERS LOG

Date: 2-4, 1964, Driller: McDonald Hill County Clarke
(Name)

(1) Owner of Land: <u>Bill Byrd</u> (Name)	Description & Color of Materials Sand, Clay, Red Clay, Shell, etc.	Thick- ness Feet	Depth Feet
<u>Enterprise, Miss</u> (Address)	<u>Clay</u>	<u>0</u>	<u>10</u>
(2) Location: <u>1/4, 1/4, Sec. 31 T. R.</u>	<u>Sand</u>	<u>15</u>	<u>25</u>
<u>2 miles S</u> of <u>Enterprise</u> (distance) (direction) (Nearest Town)	<u>Shale</u>	<u>75</u>	<u>110</u>
(3) Topography: <u>Hilly</u> (Hilly) (Flat) (Level)	<u>lime shale</u>	<u>115</u>	<u>121</u>
(4) Purpose of Well: <u>Domestic</u> (Domestic Irrigation Municipal, Industrial, Other)	<u>Hard lime</u>	<u>121</u>	<u>132</u>
	<u>sandstone</u>	<u>132</u>	<u>140</u>
	<u>silty shale</u>	<u>140</u>	<u>153</u>
	<u>stone shale</u>	<u>153</u>	<u>170</u>
	<u>sand</u>	<u>170</u>	<u>180</u>
	<u>lime & shale</u>	<u>180</u>	<u>205</u>
	<u>sand & soft shale</u>	<u>205</u>	<u>260</u>


Information upon completion of well:

- (1) Diameter 4 inches.
- (2) Total Depth 260 feet.
- (3) Water Level 40 feet below top of ground.
- (4) Cased to 155, Size 4.
- (5) Screen: Size _____, Length _____.
- (6) Were any formations sealed against pollution?
_____ yes, _____ no.

If YES depth of formation _____

Why _____

Drillers Remarks: Suggest set
sit @ 40

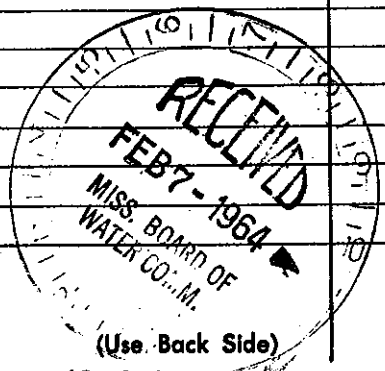

Well No. _____

Mail this copy to Board of Water Commissioners 429 Miss. St. Jackson, Miss.