

ER COMMISSIONERS

CLARKE

B34

WATER WELL DRILLERS LOG

5

8-63

Date: August, 1963, Driller: Peoples Drilling, County: Clarke

(Name)

(1) Owner of Land: Willie Rauter
(Name)

Enterprise, Miss
(Address)

(2) Location: 1/4, 1/4, Sec. 31 ^{4N15E} T. R.,

2 miles SE of Enterprise
(distance) (direction) (Nearest Town)

(3) Topography: Hilly
(Hilly) (Flat) (Level)

(4) Purpose of Well: Domestic
(Domestic Irrigation
Municipal, Industrial, Other)

Description & Color of Materials Sand, Clay, Red Clay, Shell, etc.	Thick- ness Feet	Depth Feet
yellow sandy clay	10	10
white sand	11	21
Blue marl	31	52
Rock (green)	20	72
Blue marl + Rock strata	127	199
Gray sandy shale	11	210
White sand	31	241

Information upon completion of well:

(1) Diameter 4 inches.

(2) Total Depth 241 feet.

(3) Water Level 12 feet below top of ground.

(4) Cased to 42', Size 4"


(5) Screen: Size NONE, Length _____

(6) Were any formations sealed against pollution?
_____yes, _____no.

If YES depth of formation _____

Why _____

Drillers Remarks: _____

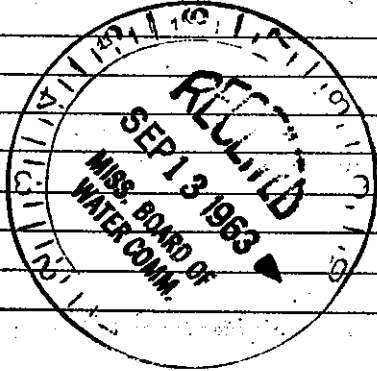

Well No.

(Use Back Side)

Mail this copy to Board of Water Commissioners 429 Miss. St. Jackson, Miss