

CLARKE
B37

MISSISSIPPI BOARD OF WATER COMMISSIONERS

5-28-62

WATER WELL DRILLERS LOG

Date: 5-28, 1962, Driller: M. E. Donald & Hill County: Clarke

(Name)

(1) Owner of Land:	Description & Color of Materials Sand, Clay, Red Clay, Shell, etc.	Thick- ness Feet	Depth Feet
(Name) <u>T. H. Kelly</u>	Clay	0	10
(Address) <u>Stone wall, Miss.</u>	Sand	10	28
(2) Location: $\frac{1}{4}$, $\frac{1}{4}$, Sec. <u>28</u> ^{4N 15E} T R	Sand st. shale	28	95
<u>3</u> miles <u>N.E.</u> of <u>Stonewall</u>	Shale	105	149
(distance) (direction) (Nearest Town)	Sand st. shale	147	160
(3) Topography: <input checked="" type="checkbox"/> (Hilly) <input type="checkbox"/> (Flat) <input type="checkbox"/> (Level)	shale	160	290
(4) Purpose of Well: <u>Domestic</u>	Sand	291	315
(Domestic Irrigation Municipal, Industrial, Other)			


Information upon completion of well:

- (1) Diameter 3 inches
- (2) Total Depth 315 feet.
- (3) Water Level 75 feet below top of ground.
- (4) Cased to 112', Size 3"
- (5) Screen: Size none, Length _____
- (6) Were any formations sealed against pollution?
 yes, no.

If YES depth of formation _____

Why _____

Drillers Remarks: _____

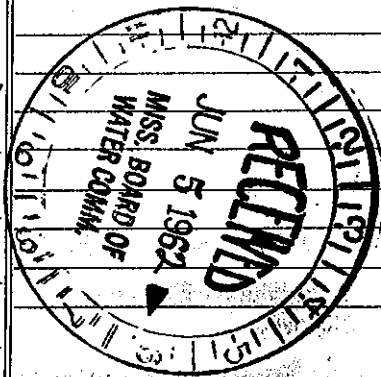

(Use Back Side)

Well No. _____

Mail this copy to Board of Water Commissioners 429 Miss. St. Jackson, Miss.