

6 CLARKE  
B 38  
4-62

MISSISSIPPI BOARD OF WATER COMMISSIONERS

P

WATER WELL DRILLERS LOG

Date: April, 1962, Driller: Peepert Bullock County Clarke  
(Name)

(1) Owner of Land: <u>Maffett</u> (Name)	Description & Color of Materials Sand, Clay, Red Clay, Shell, etc.	Thick- ness Feet	Depth Feet
(Address)	<u>Top to Red sandy clay</u>	<u>12</u>	<u>12</u>
(2) Location: <u>1/4, 1/4, Sec. 23 T. R.</u>	<u>Yellow sand</u>	<u>27</u>	<u>39</u>
<u>5</u> miles <u>east</u> of <u>Enterprise</u> (distance) (direction) (Nearest Town)	<u>White sand</u>	<u>24</u>	<u>63</u>
(3) Topography: <u>Hilly</u> (Hilly) (Flat) (Level)	<u>yellow sand</u>	<u>27</u>	<u>90</u>
(4) Purpose of Well: <u>Domestic</u> (Domestic Irrigation Municipal, Industrial, Other)			


Information upon completion of well:

- (1) Diameter 2 inches.
- (2) Total Depth 90 feet.
- (3) Water level 54 feet below top of ground.
- (4) Cased to 84', Size 2"
- (5) Screen: Size 2", Length 6'
- (6) Were any formations sealed against pollution?  
no

If YES depth of formation \_\_\_\_\_

Why \_\_\_\_\_

Drillers Remarks: \_\_\_\_\_

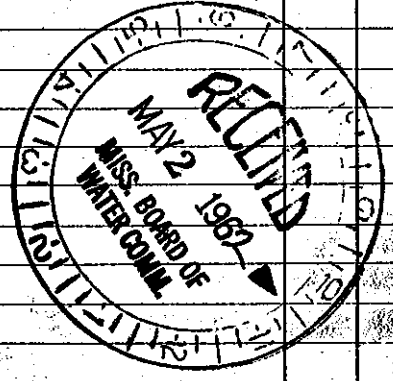

Well No. \_\_\_\_\_

(Use Back Side)

Mail this copy to Board of Water Commissioners 429 Miss. St. Jackson, Miss