

CLARKE


MISSISSIPPI BOARD OF WATER COMMISSIONERS

38 B40
2-62

WATER WELL DRILLERS LOG

Date: Feb, 1962, Driller: Peoples & Rutledge County, Clarke
(Name)

| (1) Owner of Land: <u>W. T. Heathcock</u> (Name) | Description & Color of Materials Sand, Clay, Red Clay, Shell, etc. | Thick- ness Feet | Depth Feet |
|---|---|------------------------|---------------|
| <u>Stonewall, Miss</u> (Address) | <u>top to yellow clay</u> | <u>8</u> | <u>8</u> |
| (2) Location: <u>SW 1/4, NE 1/4, Sec. 33 T. 4 R. 5 E</u> | <u>yellow sand</u> | <u>9</u> | <u>17</u> |
| <u>2</u> miles <u>E</u> , of <u>Stonewall</u> (distance) (direction) (Nearest Town) | <u>Blue marl</u> | <u>4</u> | <u>21</u> |
| (3) Topography: <u>Hilly</u> (Hilly) (Flat) (Level) | <u>yellow sandy clay & yellow sand streaks</u> | <u>28</u> | <u>49</u> |
| (4) Purpose of Well: <u>Domestic</u> (Domestic Irrigation, Municipal, Industrial, Other) | <u>white sand</u> | <u>12</u> | <u>61</u> |
| Information upon completion of well: | <u>Black lignite</u> | <u>2</u> | <u>63</u> |
| (1) Diameter <u>4</u> inches. | <u>Brown shale</u> | <u>21</u> | <u>84</u> |
| (2) Total Depth <u>315</u> feet. | <u>yellow clay</u> | <u>3</u> | <u>87</u> |
| (3) Water Level <u>97</u> feet below top of ground. | <u>White sand</u> | <u>8</u> | <u>95</u> |
| (4) Cased to <u>148</u> , Size <u>4"</u> | <u>yellow sand</u> | <u>10</u> | <u>105</u> |
| (5) Screen: Size <u>None</u> , Length _____ | <u>Brown sandy shale</u> | <u>15</u> | <u>120</u> |
| (6) Were any formations sealed against pollution? <input checked="" type="checkbox"/> yes, _____ no. | <u>Blue shale</u> | <u>12</u> | <u>132</u> |
| If YES depth of formation <u>105</u> | <u>Green Rock</u> | <u>15</u> | <u>147</u> |
| Why <u>high iron content</u> | <u>Green shale</u> | <u>4</u> | <u>151</u> |
| Drillers Remarks: _____ | <u>Green sand & chert</u> | <u>4</u> | <u>157</u> |
| _____ | <u>Green rock & small green shale streaks</u> | <u>116</u> | <u>273</u> |
| _____ | <u>gray sandy shale</u> | <u>10</u> | <u>283</u> |
| _____ | <u>white sand</u> | <u>11</u> | <u>294</u> |
| _____ | <u>white sand & small gray shale streaks</u> | <u>21</u> | <u>315</u> |

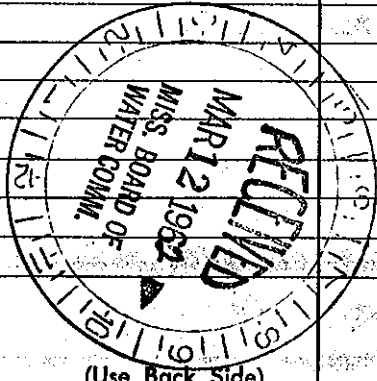

Well No.

Mail this copy to Board of Water Commissioners 429 Miss. St. Jackson, Miss