

CLARKE

MISSISSIPPI BOARD OF WATER COMMISSIONERS


4
842

2-62

WATER WELL DRILLERS LOG

Date: Feb, 1962, Driller: Peoples & Kelly County Jacks
(Name)

(1) Owner of Land: <u>Perry Dow</u> (Name)	Description & Color of Materials Sand, Clay, Red Clay, Shell, etc.	Thick- ness Feet	Depth Feet
<u>Stonewall, Miss</u> (Address)	<u>top soil to yellow sand</u>	51	51
NW Corner	<u>Black lignite</u>	2	53
(2) Location: <u>SW 1/4, NE 1/4, Sec. 33 T4 R15E</u>	<u>Dark Gray shale</u>	9	62
<u>2</u> miles <u>E</u> , of <u>Stonewall</u> (distance) (direction) (Nearest Town)	<u>white & yellow wired sand</u>	28	90
(3) Topography: <u>Hilly</u> (Hilly) (Flat) (Level)			
(4) Purpose of Well: <u>Domestic</u> (Domestic Irrigation Municipal, Industrial, Other)			
Information upon completion of well:			
(1) Diameter <u>2</u> inches.			
(2) Total Depth <u>90</u> feet.			
(3) Water Level <u>40</u> feet below top of ground.			
(4) Cased to <u>84</u> , Size <u>2"</u>			
(5) Screen: Size <u>2'</u> , Length <u>6'</u>			
(6) Were any formations sealed against pollution? <u>yes</u> , <input checked="" type="checkbox"/> no.			
If YES depth of formation			
Why			
Drillers Remarks:			

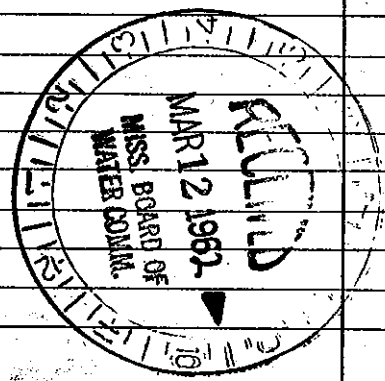

(Use Back Side)

Well No.

Mail this copy to Board of Water Commissioners 429 Miss. St. Jackson, Miss