

CLARKE
5 BB45
8-64

MISSISSIPPI BOARD OF WATER COMMISSIONERS

WATER WELL DRILLERS LOG

Date: August, 1964, Driller: Peoples Drilling Co. County Clarke
(Name)

(1) Owner of Land:	Description & Color of Materials Sand, Clay, Red Clay, Shell, etc.	Thick- ness Feet	Depth Feet
<u>Eddie Johnson</u> (Name) <u>Stonewall, Miss</u> (Address)	<u>White Sand</u>	<u>17</u>	<u>17</u>
(2) Location: <u>1/4</u> , <u>1/4</u> , Sec. <u>31</u> <u>4N 15E</u> <u>1/2</u> miles <u>N</u> , of <u>Stonewall</u> (distance) (direction) (Nearest Town)	<u>Blue shale</u>	<u>27</u>	<u>44</u>
(3) Topography: <u>flat</u> (Hilly) (Flat) (Level)	<u>Rock</u>	<u>16</u>	<u>60</u>
(4) Purpose of Well: <u>Home</u> (Domestic Irrigation Municipal, Industrial, Other)	<u>Green sand</u>	<u>13</u>	<u>73</u>
	<u>Blue marl & rock</u>	<u>63</u>	<u>136</u>
	<u>Rock & blue marl streak</u>	<u>74</u>	<u>210</u>
	<u>Blue sandy shale</u>	<u>11</u>	<u>221</u>
	<u>White sand</u>	<u>31</u>	<u>252</u>
	<u>White sand +</u>		
	<u>Gray shale streak</u>	<u>21</u>	<u>273</u>


Information upon completion of well:

- (1) Diameter 3 inches.
- (2) Total Depth 273 feet.
- (3) Water Level Flow feet below top of ground.
- (4) Cased to 84', Size 3'
- (5) Screen: Size NONE, Length _____
- (6) Were any formations sealed against pollution?
_____ yes, _____ no.

If YES depth of formation _____

Why _____

Drillers Remarks: _____

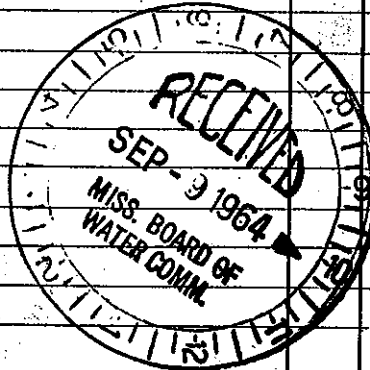

(Use Back Side)

Well No.

Mail this copy to Board of Water Commissioners 429 Miss. St. Jackson, Mis: