

CLARKE MISSISSIPPI BOARD OF WATER COMMISSIONERS

6 H B 7
2-19-64

WATER WELL DRILLERS LOG

CODED

Date: 2-19, 1964, Driller: Mc Donald & Hill County Clarke
(Name)

(1) Owner of Land: <u>Almon Haysen</u> (Name)	Description & Color of Materials Sand, Clay, Red Clay, Shell, etc.	Thick- ness Feet	Depth Feet
<u>Quitman Rt 2</u> (Address)	<u>Clay</u>	<u>0</u>	<u>25</u>
(2) Location: <u>22</u> <u>4N 16E</u> <u>T. R.</u>	<u>sand</u>	<u>25</u>	<u>43</u>
<u>10</u> miles <u>NE</u> of <u>Quitman</u> (distance) (direction) (Nearest Town)	<u>Chalk & sand</u>	<u>43</u>	<u>60</u>
(3) Topography: <u>hilly</u> (Hilly) (Flat) (Level)	<u>sand</u>	<u>60</u>	<u>66</u>
(4) Purpose of Well: <u>Domestic</u> (Domestic Irrigation Municipal, Industrial, Other)	<u>Chalk w/ shells</u>	<u>66</u>	<u>80</u>
	<u>sand</u>	<u>80</u>	<u>125</u>
	<u>shale</u>	<u>125</u>	—

CODED

Information upon completion of well:

(1) Diameter 2 inches.

(2) Total Depth 125 feet.

(3) Water Level 90 feet below top of ground.

(4) Cased to 121, Size 2"


(5) Screen: Size 2, Length 3

(6) Were any formations sealed against pollution?
_____ yes, _____ no.

If YES depth of formation _____

Why _____

Drillers Remarks: _____

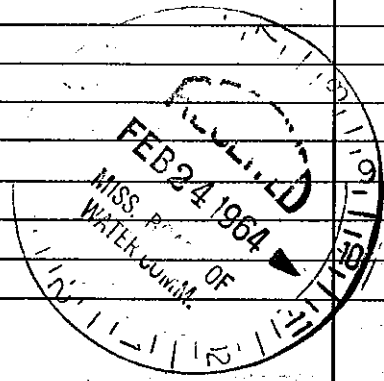

(Use Back Side)

Well No.

Mail this copy to Board of Water Commissioners 429 Miss. St. Jackson, Miss.