

Clarke
B 60

MISSISSIPPI BOARD OF WATER COMMISSIONERS

WATER WELL DRILLERS LOG

3-4-63

Date: 3-4, 1963

Driller: McDONALD & HILL, Inc.

County: Lumberton

CODED

Name: OX 81

State: MISSISSIPPI

(1) Owner of Land: Archie Charrelon
(Name)
Rt #1, Quitman, Miss
(Address)

(2) Location: 3/4, 1/4, Sec. 36 4N/5E
8 miles N of Quitman
(distance) (direction) (Nearest Town)

(3) Topography: (Hilly) (Flat) (Level)

(4) Purpose of Well: Domestic
(Domestic Irrigation, Municipal, Industrial, Other)

Description & Color of Materials Sand, Clay, Red Clay, Shell, etc.	Thick- ness Feet	Depth Feet
Clay	0	18
B. shale	18	25
Hard limy shale	25	31
B. shale	31	62
Lime & shale	62	162
med. Brown shale	162	180
#12 sand	180	181
sand with shale str.	181	207

Information upon completion of well:

(1) Diameter 3 inches.

(2) Total Depth 210 feet.

(3) Water Level 33 feet below top of ground.

(4) Cased to 159', Size 4"


(5) Screen: Size none, Length _____

(6) Were any formations sealed against pollution?
_____ yes, no.

If YES, depth of formation _____

Why _____

Drillers Remarks: _____

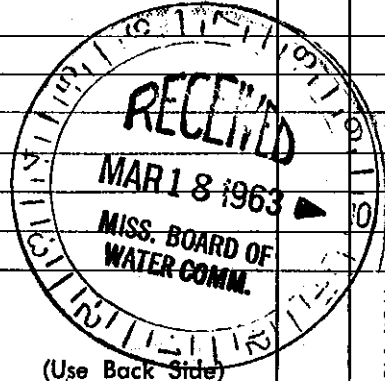

Well No.

(Use Back Side)

Mail this copy to Board of Water Commissioners 429 Miss. St. Jackson, Miss.